


CERTIFIED RECORD OF LAND CORNER MONUMENTATION

History of original corner establishment:

THIS CORNER WAS SET IN 1979
BY R.L.S. 866.

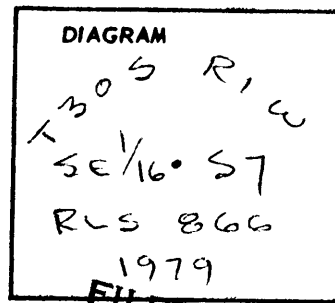

FILED

11/14
NOV 14 1986

COUNTY SURVEYOR
DOUGLAS COUNTY, ORE


Description of corner evidence found:

FOUND 2" GAL. IRON PIPE WITH 2 1/2" BRASS CAP
IN ROCK MOUND.

Description of monument and accessories I established to perpetuate the original location of this corner

FOUND A 10" FIR (DEAD) WHICH BEARS ^{N 80 1/3° E} N 80° E 48.5', SCRIBE VISIBLE
FOUND A 26" CEDAR WHICH BEARS N 16 3/4° W 20.0', SCRIBE VISIBLE
I SCRIBED A 8" FIR BT WHICH BEARS N 88° E 21.4',
MARKED SE 1/16 S 7 BT WITH L.S. 944 BRASS
WASHER NAILLED TO BT SCRIBE.

DATE: OCT., 1986

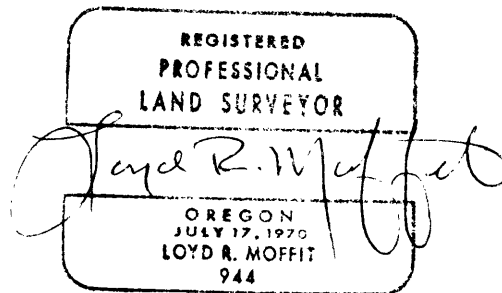

Office of.....Surveyor..... County of..... Douglas.....

State of..... Oregon....., I hereby certify that the within instrument was filed in this office
for record on the 14 day of..... November 1986

..... Fritz Ingram..... by..... Virginia Lugen.....
(COUNTY OFFICIAL) (DEPUTY)