


CERTIFIED RECORD OF LAND CORNER MONUMENTATION

History of original corner establishment:

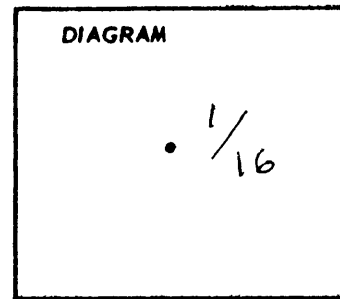

THIS CORNER IS ON THE NORTH LINE OF SECTION 4, T31S, R2W, W.M.

FILED

JF

NOV 14 1986

Description of corner evidence found:

COUNTY SURVEYOR
DOUGLAS COUNTY, ORE.

FD. 5/8" IRON REBAR WITH 1 1/4" ALUM. CAP EXPOSED 12" MARKING THE E 1/16 ON THE NORTH LINE OF SECTION 4 ONLY.

Description of monument and accessories I established to perpetuate the original location of this corner

FOUND 12" FIR BT WHICH BEARS S 38 1/2° E 16.5', SCRIBE VISIBLE. I SCRIBED A NEW BT ^{7" FIR} WHICH BEARS S 73° E 8.5', MARKED E 1/16 S 4 BT WITH LS 944 BRASS WASHER IN BT. SCRIBE.

DATE: OCT., 1986



Office of.....Surveyor..... County of.....Douglas.....
State of.....Oregon....., I hereby certify that the within instrument was filed in this office for record on the 14 day of November
Fritz Ingram by *Virginia Sargent*
(COUNTY OFFICIAL) (DEPUTY)