

CERTIFIED RECORD OF LAND CORNER MONUMENTATION

History of original corner establishment:


TOWNSHIP 21 SOUTH, RANGE 10 WEST - DOUGLAS COUNTY

In 1918, F. Mensch performed the original survey of this portion of the township. He set at this corner:

A country rock, 16" x 14" x 8", 11" in the ground, for the corner of Sections 27 and 28 only, marked with 3 notches on the East edge, from which

A 10" Alder bears S 35° E, 20 Links, marked "T21S R10W S27 BT",

A 14" Fir bears S 64° W, 31 Links, marked "T21S R10W S28 BT".

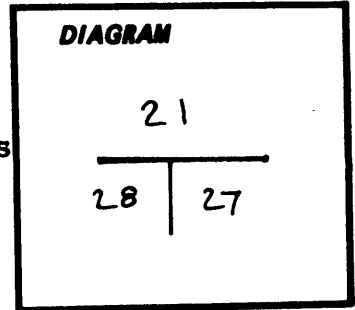

FILED

*WLS*

NOV 19 1986

Description of corner evidence found:

On October 24, 1986, I found:

A weathered sandstone, lying loose on the ground, no marks, its position too uncertain to be considered the corner.

33" Douglas Fir, S 64° W, 31 Links=20.5 feet, bark scribed "T21S R10..S28 CS", probably about 1968. A lower blaze has been cut into, with axe marks visible on the old face, but date of marks uncertain. I believe this to be the GLO BT.

Possible alder roots, rotten, S 35° E, 20 Links.


COUNTY SURVEYOR  
DOUGLAS COUNTY, ORE.

Description of monument and accessories I established to perpetuate the original location of this corner:

From the standing BT, I set an aluminum Forest Service monument, 2 1/2" x 30" with 3/4" aluminum cap, set 25" deep, using the found stone and other sandstones as a small collar.

The corner is on a steep (45°) North-westerly-facing slope in old growth timber and brush, about 75' West of FS road #4100-147.

I marked a 20" Douglas Fir, bears S 33°W, 28.1 ft, scribed "T21S R10W S28 BT", with brass washer (LS 909), Land Survey Monument sign, BT sign, and red paint.

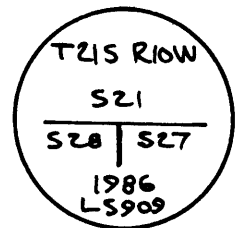

REGISTERED  
PROFESSIONAL  
LAND SURVEYOR

*William L. Shull*

OREGON  
JULY 11, 1969  
WILLIAM L. SHULL  
909

William L. Shull, LS 909  
Witness: David Weston

Declination: 20° East, on K&E staff compass.

Office of.....Surveyor..... County of.....Douglas.....  
State of.....Oregon..... I hereby certify that the within instrument was filed in this office  
for record on the...19... day of...November..... 19...86  
.....Fritz Ingram..... by *Virginia A. Sargent*.....  
(COUNTY OFFICIAL) (DEPUTY)