


CERTIFIED RECORD OF LAND CORNER MONUMENTATION

History of original corner establishment:

THIS CORNER WAS SET IN 1966
BY THE COUNTY SURVEYORS OFFICE.

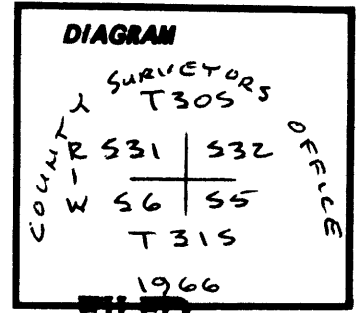

DEC 31 1986

COUNTY SURVEYOR
DOUGLAS COUNTY, ORE.


Description of corner evidence found:

- Found A 2 1/2" BRASS CAP ON A 1" IRON PIPE
- Found 24" ROTTED FIR STUMP WHICH BEARS N 02° E 21.8'
- Found 12" FIR WHICH BEARS N 80° E 40.8', SCAR VISIBLE.
- Found 18" DEAD FIR WHICH BEARS S 52° E 51.3', SCRIBE VISIBLE.
- Found 14" FIR WHICH BEARS S 35° W 9.2', SCAR VISIBLE.
- Found 26" DEAD FIR WHICH BEARS S 72° W 21.2', SCRIBE VISIBLE.
- Found 16" FIR WHICH BEARS N 56° W 140.1', SCRIBE VISIBLE.
- Found 27" UPROOTED FIR WHICH BEARS N 20° W 15.2'
- Found 24" FIR WHICH BEARS N 89° W 23.0', SCAR VISIBLE (ORIGIN UNKNOWN).

Description of monument and accessories I established to perpetuate the original location of this corner:

I MARKED A 7" CEDAR WHICH BEARS S 40° E 62.8'
FROM THE CORNER, SCRIBED T 315 RIW S 5 BT,
WITH L.S. WASHER # 944 NAILED TO BT SCRIBE.

DATE: DEC., 1986

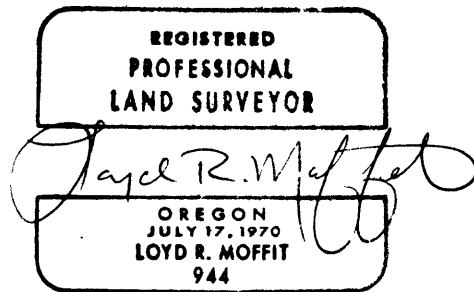

Office of... Surveyor County of... Douglas
 State of... Oregon I hereby certify that the within instrument was filed in this office
 for record on the... 31... day of... December..... 1986
 Fritz Ingram by Virginia A. Langer
 (COUNTY OFFICIAL) (DEPUTY)

Form R6-7100-57 (9/71)

☆ GPO-798-276

237 T30-1 ✓
207 T31-1 ✓

C.S. FILE NO. 62/30-19