


CERTIFIED RECORD OF LAND CORNER MONUMENTATION

History of original corner establishment:

THIS CORNER WAS SET IN 1961
BY THE COUNTY SURVEYOR'S OFFICE

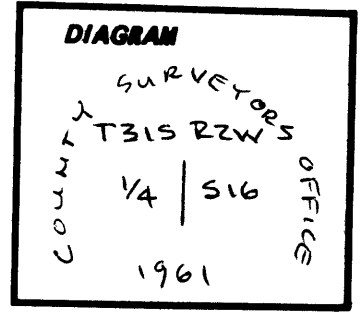

FILED

JL

DEC 31 1986

COUNTY SURVEYOR
DOUGLAS COUNTY, ORE.

Description of corner evidence found:

- Found 1" IRON PIPE WITH 2 1/2" BRASS CAP.
- Found FIR STUMP S 32 1/2° E 23.1'
- Found 14" CEDAR N 30° E 35.1', SCRIBE VISIBLE.
- FD. FIR STUMP S 83° E 31.4', SCRIBE VISIBLE.
- FD. FIR STUMP S 21° W 17.8'

Description of monument and accessories I established to perpetuate the original location of this corner:

I MARKED A 9" FIR WHICH BEARS N 80 1/2° W 4.7',
SCRIBED 1/4 S 16 BT, WITH L.S. WASHER NO. 944
NAILED TO BT SCRIBE

DATE: Nov., 1986

Office of.....SURVEYOR..... County of.....Douglas.....
 State of.....Oregon....., I hereby certify that the within instrument was filed in this office
 for record on the...31... day of...December....., 1986
 Fritz Ingram
 (COUNTY OFFICIAL) by *Virginia A. Saugen*
 (DEPUTY)

Form R6-7100-57 (9/71)

☆ GPO-798-276

227 4

C.S. File No. 62/30-20
C