


CERTIFIED RECORD OF LAND CORNER MONUMENTATION

History of original corner establishment:

THIS CORNER WAS SET IN
1979 BY P.L.S. 536.

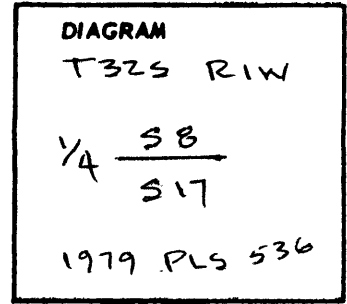

FILED

JL

DEC 31 1986

COUNTY SURVEYOR
DOUGLAS COUNTY, ORE.

Description of corner evidence found:

Found A 2" IRON PIPE WITH A 3" BRASS CAP
Found A 24" LAUREL WHICH BEARS S78°W 103.7', SCRIBE VISIBLE.
Found DEAD CEDAR WHICH BEARS N46°W 92.0', SCRIBE VISIBLE.

Description of monument and accessories I established to perpetuate the original location of this corner

I MARKED A 8" FIR WHICH BEARS N46 3/4° W 94.3',
SCRIBED 1/4 S8 BT WITH LS WASHER NO. 944
NAILED TO BT SCRIBE.

DATE: Nov., 1986



Office of... Surveyor..... County of... Douglas.....
 State of... Oregon....., I hereby certify that the within instrument was filed in this office
 for record on the 31 day of December..... 1986
 Fritz Ingram..... by *Virginia A. Larsen*.....
 (COUNTY OFFICIAL) (DEPUTY)

#101 ✓

C