


CERTIFIED RECORD OF LAND CORNER MONUMENTATION

History of original corner establishment:

THIS CORNER WAS SET IN 1977 BY  
L.S. 1005.

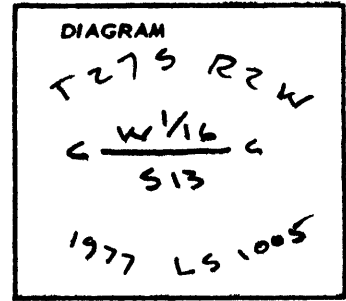

Description of corner evidence found:

Found A 3" BRASS CAP ON A 2" IRON PIPE IN A ROCK  
MOUND, FROM WHICH;

A 16" HEMLOCK STUMP BEARS N 65° W 38.8', SCRIBE VISIBLE.

A 11" YEW WOOD STUMP BEARS N 03° E 53.8', SCRIBE VISIBLE.


A 3/4" REBAR BEARS N 26° W 6.3'

Description of monument and accessories I established to perpetuate the  
original location of this corner

I MARKED; A 9" CEDAR B.T. WHICH BEARS N 11° E 14.4', SCRIBED CW 1/16 S 13 BT.

A 10" HEMLOCK B.T. WHICH BEARS N 08° W 24.5', SCRIBED CW 1/16 S 13 BT.

I NAILED A L.S. 944 BRASS WASHER TO BOTH BT SCRIBES.

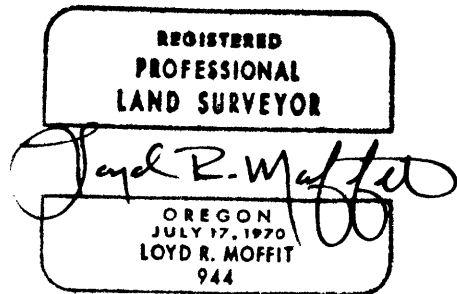

FILED  
JUN 5 1986  
COUNTY SURVEYOR  
DOUGLAS COUNTY, ORE

Office of Surveyor ..... County of Douglas

State of Oregon

for record on the 5 day of June

Fritz Ingram  
(COUNTY OFFICIAL)

by Virginia A. Langston  
(DEPUTY)