


CERTIFIED RECORD OF LAND CORNER MONUMENTATION

History of original corner establishment:

THIS CORNER WAS SET IN 1977
BY L.S. 1005.

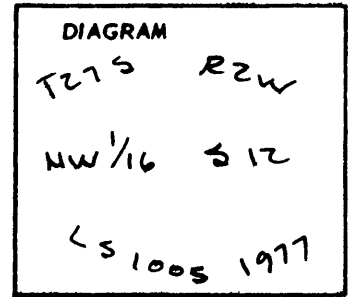

Description of corner evidence found:

FOUND A 3" BRASS CAP ON A 2" IRON PIPE 3" BELOW SURFACE, IN A ROCK MOUND, FROM WHICH;


A 28" FIR STUMP BEARS N 50° E 71.0', SCRIBE VISIBLE.

A 14" HEMLOCK STUMP BEARS S 36 1/2° W 18.9', SCRIBE VISIBLE.

Description of monument and accessories I established to perpetuate the original location of this corner

I MARKED; A 6" FIR B.T. WHICH BEARS N 2 1/2° E 116.0', SCRIBED NW 1/16 S 12 BT
A 12" FIR B.T. WHICH BEARS S 82° E 117.8', SCRIBED NW 1/16 S 12 BT

I NAILED A L.S. 944 BRASS WASHER TO BOTH BT SCRIBES.

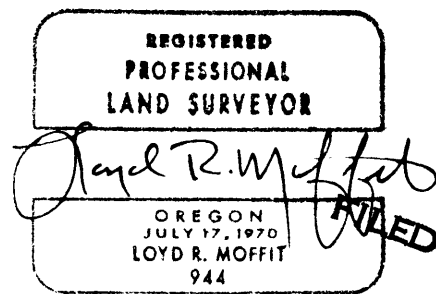

JUN 5 1986
COUNTY SURVEYOR
DOUGLAS COUNTY, ORE.

Office of Surveyor County of Douglas
 State of Oregon, I hereby certify that the within instrument was filed in this office
 for record on the 5 day of June
 Fritz Ingram by Virginia A. Ingram
 (COUNTY OFFICIAL) (DEPUTY)