


CERTIFIED RECORD OF LAND CORNER MONUMENTATION

History of original corner establishment:

THIS CORNER WAS REESTABLISHED
IN 1977 BY THE DOUGLAS COUNTY SURVEYOR'S
OFFICE.

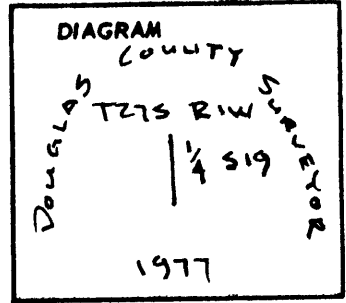


Description of corner evidence found:

FOUND 2" BRASS CAP ON A 1" IRON PIPE IN A ROCK MOUND,
FROM WHICH;
A 40" FIR STUMP BEARS S38°E 24.4', SCRIBE VISIBLE.
A 38" FIR STUMP BEARS N10°W 10.6', SCRIBE VISIBLE.

Description of monument and accessories I established to perpetuate the
original location of this corner

I MARKED; A 4" FIR WHICH BEARS S64°E 7.7', SCRIBED "X" BT
A 6" FIR WHICH BEARS S23°E 36.7', SCRIBED 1/4 S19 BT
I NAILED A L.S. 944 BRASS WASHER TO BOTH ^{BT} SCRIBES.

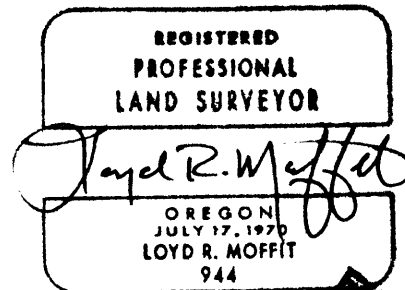

Office of Surveyor County of Douglas
Oregon
State of Oregon, I hereby certify that the within instrument was filed in this office
for record on the 5 day of June
Fritz Ingram by Virginia G. Saenger
(COUNTY OFFICIAL) (DEPUTY)

FILED
JUN 5 1986
COUNTY SURVEYOR
DOUGLAS COUNTY, ORE

#246 T. 27-2
#192 T. 27-1
Form R6-7100-57 (9/71)