


CERTIFIED RECORD OF LAND CORNER MONUMENTATION

History of original corner establishment:

THIS CORNER WAS MONUMENTED BY
R.E. 4287.

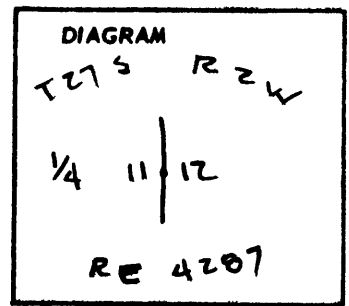

Description of corner evidence found:

FOUND A 2 1/2" ALUM. CAP ON 3/4" IRON PIPE WITH ORIGINAL
CORNER STONE ALONG SIDE, FROM WHICH;

A 10" FIR (DOWN & DEAD) BEARS S 72° E 34.3', SCRIBE VISIBLE (O.B.T.)


A 14" FIR BEARS S 18° E 3.9', SCAR VISIBLE.

A 8" HEMLOCK (DOWN & DEAD) BEARS S 30° W 26.3', SCRIBE VISIBLE.

*101

Description of monument and accessories I established to perpetuate the original location of this corner

I MARKED A 12" CEDAR B.T. WHICH BEARS S 28° W
85.0' FROM THE CORNER, SCRIBED 1/4 5 11 BT. NAILED
A L.S. 944 BRASS WASHER TO BT SCRIBE.

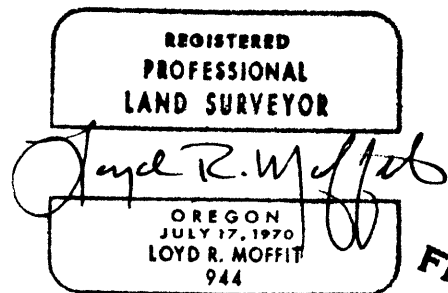

FILED

JUN 5 1986

COUNTY SURVEYOR
DOUGLAS COUNTY, ORE

Office of Surveyor County of Douglas
 State of Oregon, I hereby certify that the within instrument was filed in this office
 for record on the 5 day of June
Fritz Ingram by Virginia A. Langston
 (COUNTY OFFICIAL) (DEPUTY)

c