


CERTIFIED RECORD OF LAND CORNER MONUMENTATION

History of original corner establishment:

THIS CORNER WAS REMONUMENTED IN 1968 BY THE DOUGLAS COUNTY SURVEYOR'S OFFICE.

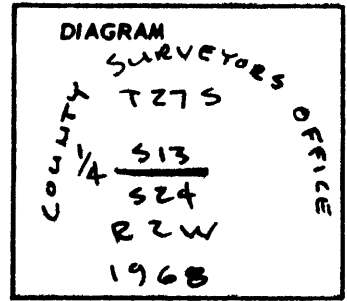

Description of corner evidence found:

FOUND A 2 1/2" BRASS CAP ON A 1" IRON PIPE EXPOSED 12" SET UNDER THE ORIGINAL OAK CORNER TREE (NO SCRIBES VISIBLE ON TREE), FROM WHICH;

A 8" FIR SNAQ BEARS N 55° E 8.0', SCRIBE VISIBLE.

A 18" FIR BEARS S 05° W 15.2', SCRIBE VISIBLE.

78

Description of monument and accessories I established to perpetuate the original location of this corner

I MARKED A 32" FIR B.T. WHICH BEARS N 86° E 57.1' FROM THE CORNER, SCRIBED 1/4 513 B.T. NAILED U.S. 944 BRASS WASHER TO B.T. SCRIBE.

REGISTERED PROFESSIONAL LAND SURVEYOR

Lloyd R. Moffitt

OREGON
JULY 17, 1974
LOYD R. MOFFITT
944

FILED

JUN 5 1986
COUNTY SURVEYOR
DOUGLAS COUNTY, ORE

Office of Surveyor..... County of..... Douglas.....

State of Oregon....., I hereby certify that the within instrument was filed in this office

for record on the 5 day of June

Fritz Ingram
(COUNTY OFFICIAL)

by *Virginia A. Senger*
(DEPUTY)

2444

C