


CERTIFIED RECORD OF LAND CORNER MONUMENTATION

History of original corner establishment:

THIS CORNER WAS SET IN 1977 BY L.S. 1005.

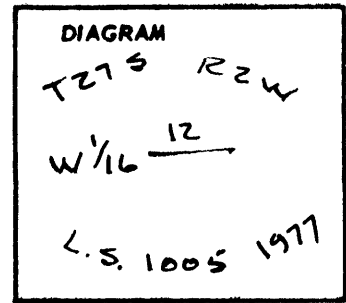

Description of corner evidence found:

Found A 3" BRASS CAP ON A 2" IRON PIPE IN A ROCK MOUND FROM WHICH;


A 38" CEDAR STUMP BEARS N 78° E 25.4', SCRIBE VISIBLE.

A 8" HEMLOCK BEARS N 43 1/2° W 8.6 FEET, SCRIBE VISIBLE

A 3/4" IRON ROD BEARS N 35° W 12.5'

Description of monument and accessories I established to perpetuate the original location of this corner

SINCE THERE WERE NO SUITABLE TREES TO SCRIBE IN SEC. 12, I MARKED A 8" FIR B.T. WHICH BEARS S 17° W 28.6', SCRIBED W 1/16 S 12 BT. NAILED A L.S. 944 BRASS WASHER TO B.T. SCRIBE.

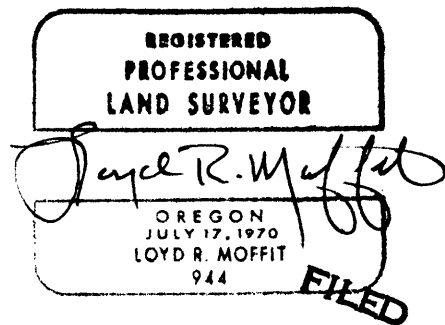

JUN 5 1986  
 COUNTY SURVEYOR  
 DOUGLAS COUNTY, ORE

Office of Surveyor ..... County of Douglas .....  
 State of Oregon ..... I hereby certify that the within instrument was filed in this office  
 for record on the 5 day of June .....  
 Fritz Ingram ..... by Virginia A. Hansen .....  
 (COUNTY OFFICIAL) (DEPUTY)