


CERTIFIED RECORD OF LAND CORNER MONUMENTATION

History of original corner establishment:

THIS CORNER WAS SET IN 1977
BY L.S. 1005.

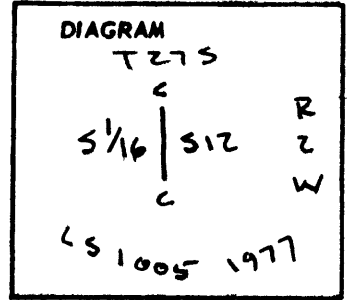


Description of corner evidence found:

FOUND A 3" BRASS CAP ON A 2" IRON PIPE IN A ROCK MOUND
FROM WHICH;

- A 22" FIR BEARS S 30 1/2° E 38.3', SCRIBE VISIBLE.
- A 32" PINE STUMP BEARS S 73° W 24.0', SCRIBE VISIBLE.
- A 3/4" REBAR BEARS NORTH I 20'

Description of monument and accessories I established to perpetuate the original location of this corner

I MARKED A 17" CEDAR B.T. WHICH BEARS N 19° E
62.1' FROM THE CORNER, SCRIBED CS 1/16 S12 BT. NAILED
A L.S. 944 BRASS WASHER TO BT SCRIBE.

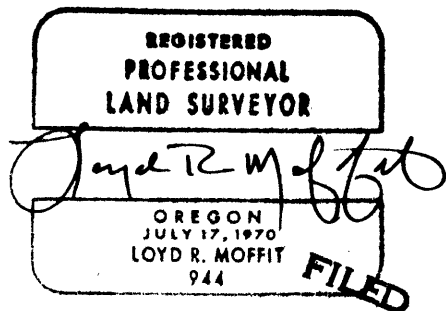

JL
JUN 5 1986
COUNTY SURVEYOR
DOUGLAS COUNTY, ORE.

Office of Surveyor County of Douglas
State of Oregon, I hereby certify that the within instrument was filed in this office
for record on the 5 day of June
Fritz Ingram by Virginia B. Ingram
(COUNTY OFFICIAL) (DEPUTY)