


CERTIFIED RECORD OF LAND CORNER MONUMENTATION

History of original corner establishment:

THIS CORNER WAS SET IN 1978 BY
L.S. # 1068.

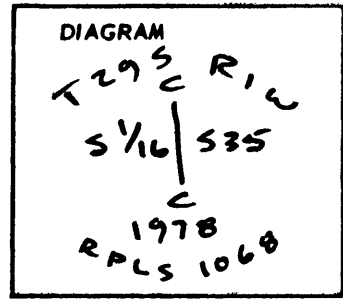


Description of corner evidence found:

FD. 2 1/2" BRASS CAP ON 2" IRON PIPE.

Description of monument and accessories I established to perpetuate the original location of this corner

I MARKED A 4" FIR BT WHICH BEARS N 64° E 8.4 FEET FROM THE CORNER, SCRIBED "X" BT.

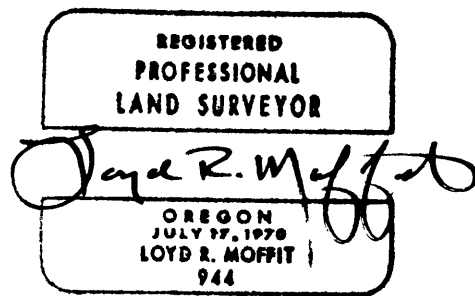

717 W. 10TH ST
MEDFORD, OR

Office of COUNTY SURVEYOR County of DOUGLAS
 State of OREGON, I hereby certify that the within instrument was filed in this office
 for record on the 6 day of January 1986
Fritz Ingram by Virginia Langen
 (COUNTY OFFICIAL) (DEPUTY)