


CERTIFIED RECORD OF LAND CORNER MONUMENTATION

History of original corner establishment:

THIS CORNER WAS RE-MONUMENTED IN 1967 BY R.E. 4287.

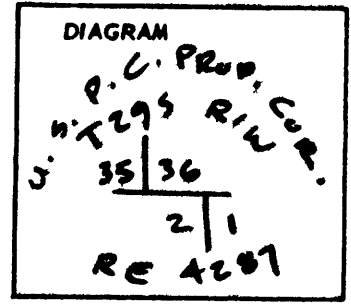


Description of corner evidence found:

FD. 3/4" IRON PIPE WITH 2 1/2" ALUM. CAP EXPOSED 14"

Description of monument and accessories I established to perpetuate the original location of this corner

I MARKED A 10" CEDAR BT WHICH BEARS N 50° W 71.9 FEET FROM THE CORNER, SCRIBED T295 RIW S 35 BT.

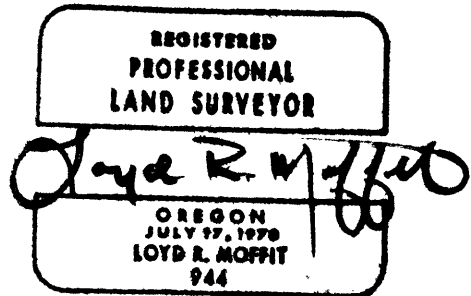

717 W. 10TH ST  
MEDFORD, OR.

Office of COUNTY SURVEYOR County of DOUGLAS  
 State of OREGON, I hereby certify that the within instrument was filed in this office  
 for record on the 6 day of January 1986  
Fritz Ingram by Virginia Lazenby  
 (COUNTY OFFICIAL) (DEPUTY)

#230 T30-1 x  
#153 T29-1 x