


CERTIFIED RECORD OF LAND CORNER MONUMENTATION

History of original corner establishment:

THIS CORNER WAS SET IN 1978 BY
L.S. 1068.

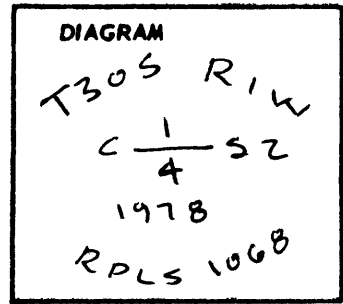

Description of corner evidence found:

FD. 2" IRON PIPE WITH A 2 1/2" BRASS CAP EXPOSED 7"
IN SMALL ROCK MOUND.

Description of monument and accessories I established to perpetuate the original location of this corner

I MARKED A 14" FIR BT WHICH BEARS S 15° E 16.4'
FROM THE CORNER, SCRIBED C 1/4 S2 BT.

REGISTERED
PROFESSIONAL
LAND SURVEYOR

Lloyd R. Moffit
OREGON
JULY 17, 1978
LOYD R. MOFFIT
944

717 W. 10 TH ST
MEDFORD, OR

Office of COUNTY SURVEYOR County of DOUGLAS
State of OREGON, I hereby certify that the within instrument was filed in this office
for record on the 6 day of January 1986
Fritz Ingram by *Virginia Layton*
(COUNTY OFFICIAL) (DEPUTY)

2324

C