


CERTIFIED RECORD OF LAND CORNER MONUMENTATION

History of original corner establishment:

THIS CORNER WAS SET IN 1967 BY  
R.E. 4287

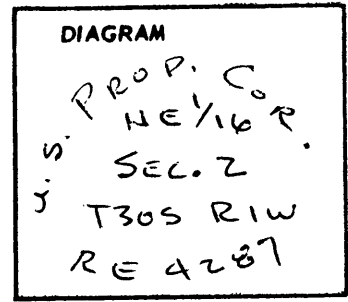

Description of corner evidence found:

FD. 3/4" IRON PIPE WITH 2 1/2" ALUM. CAP EXPOSED 14"

Description of monument and accessories I established to perpetuate the original location of this corner

I MARKED,  
A 26" FIR BT WHICH BEARS S 20° W 27.0', SCRIBED NE 1/16 S2 BT.  
A 6" FIR BT WHICH BEARS N 79° W 8.8', SCRIBED NE 1/16 S2 BT.

REGISTERED  
PROFESSIONAL  
LAND SURVEYOR

*Lloyd R. Moffit*  
OREGON  
JULY 17, 1970  
LOYD R. MOFFIT  
944

717 W. 10 TH ST  
MED FORD, OR.

Office of COUNTY SURVEYOR County of DOUGLAS  
State of OREGON, I hereby certify that the within instrument was filed in this office  
for record on the 6 day of January 1986  
Fritz Ingram by *Virginia Lanyon*  
(COUNTY OFFICIAL) (DEPUTY)