


CERTIFIED RECORD OF LAND CORNER MONUMENTATION

History of original corner establishment:

THIS CORNER WAS SET IN 1967 BY
R.E. 4287

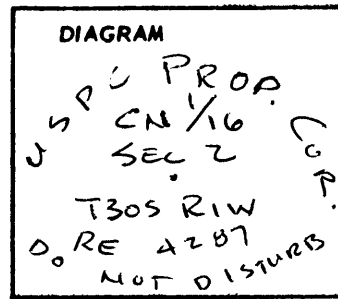


Description of corner evidence found:

FD 2 1/2" ALUM. CAP ON 3/4" IRON PIPE

Description of monument and accessories I established to perpetuate the original location of this corner

I MARKED A 6" FIR BT WHICH BEARS S46°W 8.6' FROM THE CORNER, SCRIBED CN 1/16 S2 BT.

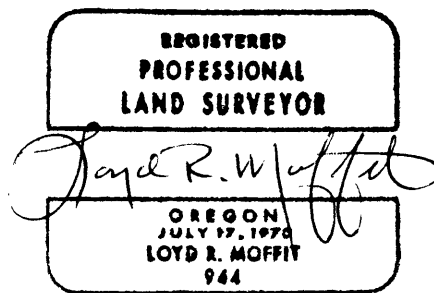

717 W. 10TH ST
MEDFORD, OR

Office of COUNTY SURVEYOR County of DOUGLAS
 State of OREGON, I hereby certify that the within instrument was filed in this office
 for record on the 6 day of January 1986
Fritz Ingram by Virginia Sargent
 (COUNTY OFFICIAL) (DEPUTY)