


CERTIFIED RECORD OF LAND CORNER MONUMENTATION

History of original corner establishment:

THIS CORNER WAS SET IN 1978
BY L.S. 1068.

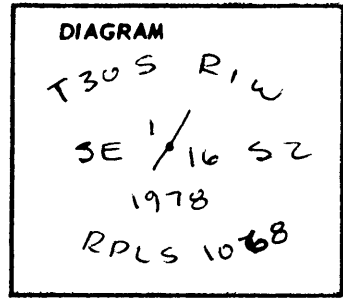

Description of corner evidence found:

FD. 2" IRON PIPE WITH 2 1/2" BRASS CAP EXPOSED 6" IN
SMALL ROCK MOUND.

Description of monument and accessories I established to perpetuate the
original location of this corner

I MARKED A 15" FIR BT WHICH BEARS N 89° W 18.7
FEET FROM THE CORNER, SCRIBED SE 1/16 S2 BT.

REGISTERED
PROFESSIONAL
LAND SURVEYOR

Lloyd R. Moffitt

OREGON
JULY 17, 1978
LOYD R. MOFFITT
944

717 W. 10TH ST
MEDFORD, OR.

Office of COUNTY SURVEYOR County of DOUGLAS
OREGON
State of OREGON, I hereby certify that the within instrument was filed in this office
for record on the 6 day of January 1986
Fritz Ingram by *Virginia Taylor*
(COUNTY OFFICIAL) (DEPUTY)