


CERTIFIED RECORD OF LAND CORNER MONUMENTATION

History of original corner establishment:

THIS CORNER WAS REMONUMENTED IN 1968 BY THE DOUGLAS COUNTY SURVEYOR'S OFFICE.

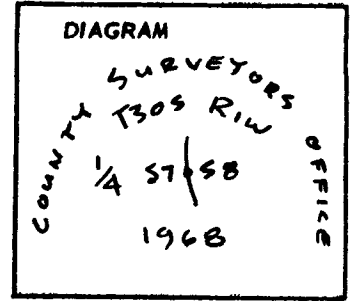


Description of corner evidence found:

Found 2 1/2" BRASS CAP ON 1" IRON PIPE EXPOSED 12", FROM WHICH:  
A 26" HEMLOCK (DEAD) BEARS N48°E 12.4', SCRIBE VISIBLE.  
A 24" HEMLOCK BEARS S26°E 39.6', SCRIBE VISIBLE.  
A HEMLOCK (DOWN) BEARS N18°W 22.3', SCRIBE VISIBLE.

Description of monument and accessories I established to perpetuate the original location of this corner

I MARKED A 7" FIR BT WHICH BEARS N67 1/2°W 29.8' FROM THE CORNER, SCRIBED 1/4 S 7 BT. NAILED L.S. 944 BRASS WASHER TO BT SCRIBE.

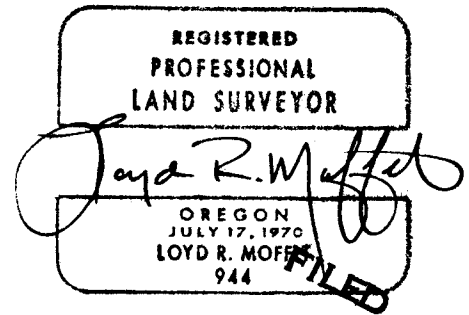

MAY 2 1986  
COUNTY SURVEYOR  
DOUGLAS COUNTY, ORE.

Office of... Surveyor..... County of... Douglas  
State of... Oregon....., I hereby certify that the within instrument was filed in this office  
for record on the 2nd day of... May..... 1986  
Fritz Ingram..... by *Lloyd R. Moffet*.....  
(COUNTY OFFICIAL) (DEPUTY)

#235 4

C