


CERTIFIED RECORD OF LAND CORNER MONUMENTATION

History of original corner establishment:

THIS CORNER WAS RE-MONUMENTED IN 1969 BY THE COUNTY SURVEYORS OFFICE.

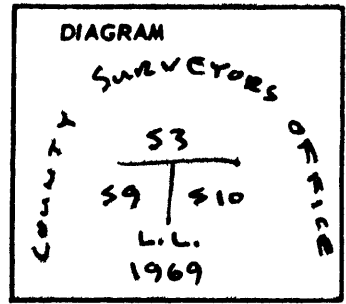

Description of corner evidence found:

FD. 1" IRON PIPE WITH 2 1/2" BRASS CAP EXPOSED 16" IN SMALL ROCK MOUND.

Description of monument and accessories I established to perpetuate the original location of this corner

I MARKED A NEW 15" CEDAR B.T. WHICH BEARS S 33 1/2° E 102.1 FEET FROM THE CORNER, SCRIBED T30S RIW S10 BT WITH BRASS L.S TAG # 944 IN LOWER PART OF BLAZE.



717 W 10 TH ST
MEDFORD, OR.

Office of COUNTY SURVEYOR County of DOUGLAS
 State of OREGON, I hereby certify that the within instrument was filed in this office
 for record on the 6 day of January 1986
Fritz Ingram by Virginia Sanger
 (COUNTY OFFICIAL) (DEPUTY)