


CERTIFIED RECORD OF LAND CORNER MONUMENTATION

History of original corner establishment:

THIS CORNER WAS RE-MONUMENTED IN 1968 BY THE COUNTY SURVEYORS OFFICE.

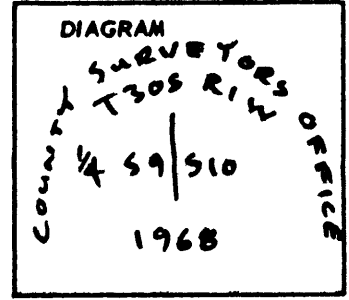

Description of corner evidence found:

FD. 2 1/2" BRASS CAP ON 1" IRON PIPE EXPOSED 16".

Description of monument and accessories I established to perpetuate the original location of this corner

I MARKED A NEW 8" OAK BT WHICH BEARS S 56° E 97.7 FEET FROM THE CORNER, SCRIBED 1/4 S 10 BT.

REGISTERED PROFESSIONAL LAND SURVEYOR

Lloyd R. Moffit
OREGON
JULY 17, 1978
LOYD R. MOFFIT
944

717 W. 10TH ST
MEDFORD, OR.

Office of COUNTY SURVEYOR County of DOUGLAS
State of OREGON, I hereby certify that the within instrument was filed in this office
for record on the 6 day of January 1986
Fritz Ingram by Virginia Layton
(COUNTY OFFICIAL) (DEPUTY)

#231 +