


CERTIFIED RECORD OF LAND CORNER MONUMENTATION

History of original corner establishment:

THIS CORNER WAS ESTABLISHED IN 1978
BY L.S. # 1068

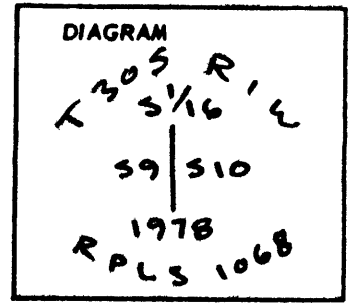


Description of corner evidence found:

FD. 2 1/2" BRASS CAP ON 2" PIPE IN SMALL ROCK MOUND.

Description of monument and accessories I established to perpetuate the original location of this corner

I SCRIBED A 14" PINE WHICH BEARS N04°E
41.9 FEET FROM THE CORNER MARKED S 1/16
S 10 BT.

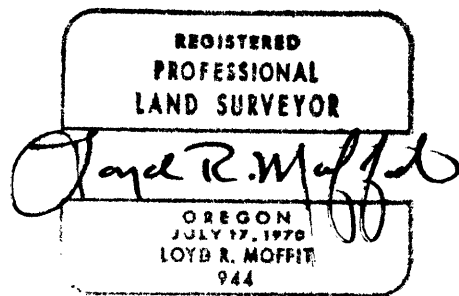

717 W. 10TH ST
MEDFORD, OR

Office of COUNTY SURVEYOR County of DOUGLAS
 State of OREGON, I hereby certify that the within instrument was filed in this office
 for record on the 6 day of January 1986
Fritz Ingram by Virginia Rausen
 (COUNTY OFFICIAL) (DEPUTY)