


CERTIFIED RECORD OF LAND CORNER MONUMENTATION

History of original corner establishment:

THIS CORNER WAS RE-MONUMENTED
IN 1968 BY THE COUNTY SURVEYOR'S OFFICE.

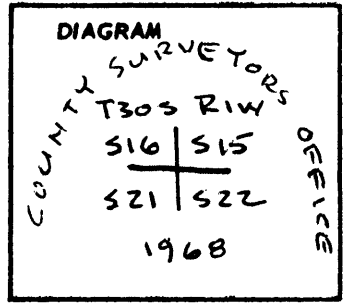

Description of corner evidence found:

FOUND A 2 1/2" BRASS CAP ON 1" IRON PIPE EXPOSED 8".

Description of monument and accessories I established to perpetuate the original location of this corner

I MARKED A 9" FIR BT WHICH BEARS N 73° E 8.5',
SCRIBED T305 RIW S15 BT.

REGISTERED
PROFESSIONAL
LAND SURVEYOR

Loyd R. Moffit

OREGON
JULY 17, 1973
LOYD R. MOFFIT
944

717 W. 10TH ST
MEDFORD, OR.

Office of COUNTY SURVEYOR County of DOUGLAS
State of OREGON , I hereby certify that the within instrument was filed in this office
for record on the 6 day of January 1980
Fritz Ingram by *Virginia Larsen*
(COUNTY OFFICIAL) (DEPUTY)

#2934

C