


CERTIFIED RECORD OF LAND CORNER MONUMENTATION

7.31-1

History of original corner establishment:

THIS CORNER WAS SET IN 1923 BY THE G.L.O.

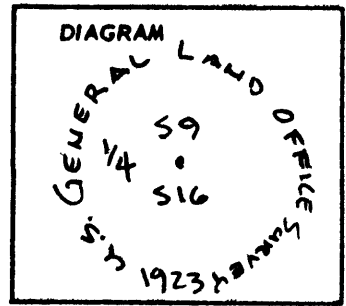


Description of corner evidence found:

FD. 3/4" IRON PIPE WITH 2 1/2" BRASS CAP FROM WHICH:

- A 36" FIR STUMP BEARS N 65° E 44.0', SCAR VISIBLE.
- A 9" HEMLOCK BEARS S 05° W 95.0', SCRIBE VISIBLE.
- A CEDAR SNAG (DOWN) BEARS S 81° W 23.8', HAS OPEN FACE.
- A 14" FIR (DEAD) BEARS N 32° 30' W 114.6', SCRIBE VISIBLE.

Description of monument and accessories I established to perpetuate the original location of this corner

I MARKED A 3" FIR BT WHICH BEARS N 46° W 5.5',
 SCRIBED "X" BT. NAILED BRASS WASHER STAMPED
 L.S. 944 TO BT SCRIBE.

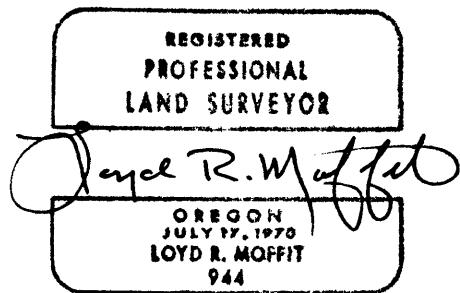

Office of County Surveyor County of Douglas
 State of Oregon, I hereby certify that the within instrument was filed in this office
 for record on the 29 day of January 1986
Fritz Ingram
 (COUNTY OFFICIAL) by Virginia Langeron
 (DEPUTY)

Handwritten initials

204

C