


CERTIFIED RECORD OF LAND CORNER MONUMENTATION

History of original corner establishment:

THIS CORNER WAS REMONUMENTED IN 1922 BY THE GENERAL LAND OFFICE.

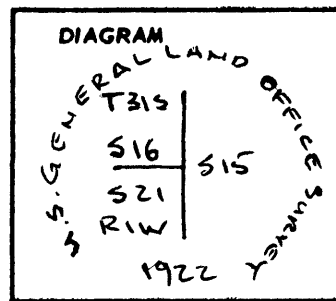


Description of corner evidence found:

FD. A 2 1/2 INCH BRASS CAP ON A 1/4 INCH IRON PIPE IN SMALL ROCK MOUND, FROM WHICH;  
 A 32" FIR BEARS N 40° E 27.6', SCRIBE VISIBLE.  
 A 16" FIR STUMP WITH 5/8" REBAR IN TOP BEARS S 05° W 29.6', SCAR VISIBLE.  
 A 40" FIR STUMP WITH 5/8" REBAR IN TOP BEARS N 45° W 2.6', SCAR VISIBLE.  
 NOTE: NO LIVE TREES FOR BT'S AVAILABLE IN N.W. QUAD.

Description of monument and accessories I established to perpetuate the original location of this corner

SINCE THERE ARE NO LIVE TREES AVAILABLE IN THE NORTHWEST QUADRANT, I MARKED A 8 INCH PINE BT WHICH BEARS S 24° W 7.1 FEET FROM THE CORNER, SCRIBED T315 RIW S21 BT. NALLED U.S. 944 BRASS WASHER TO BT SCRIBE.

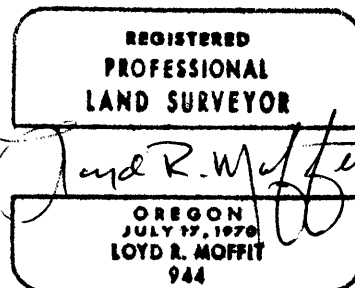

Office of County Surveyor County of Douglas  
 State of Oregon, I hereby certify that the within instrument was filed in this office  
 for record on the 29 day of January 1986  
Fritz Ingram by Virginia Sargent  
 (COUNTY OFFICIAL) (DEPUTY)

*OK  
Jm*