


CERTIFIED RECORD OF LAND CORNER MONUMENTATION

History of original corner establishment:

THIS CORNER WAS REMONUMENTED IN 1968 BY THE DOUGLAS COUNTY SURVEYOR'S OFFICE.

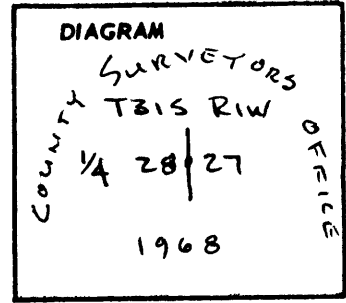

Description of corner evidence found:

FD. 16" FIR AS CORNER TREE. FD 2 1/2" BRASS CAP ON 1" IRON PIPE EXPOSED 12" SET ON SOUTH SIDE OF TREE, FROM WHICH ?

A 14" FIR BEARS S 05° E 36.5', SCAR VISIBLE.

A 7" FIR (DEAD & DOWN) BEARS S 30° W 6.1', SCAR VISIBLE.

Description of monument and accessories I established to perpetuate the original location of this corner

I MARKED A 9" FIR BT WHICH BEARS S 16° 30' W 29.4 FEET FROM THE CORNER, SCRIBED 1/4 S 28 BT. NAILED L.S. 944 BRASS WASHER TO BT SCRIBE.

REGISTERED PROFESSIONAL LAND SURVEYOR

Loyd R. Moffit

OREGON JULY 17, 1979 LOYD R. MOFFIT 944

OK

Office of County Surveyor County of Douglas
State of Oregon, I hereby certify that the within instrument was filed in this office for record on the 29 day of January 1986.
Fritz Ingram by Virginia Langen
(COUNTY OFFICIAL) (DEPUTY)