


CERTIFIED RECORD OF LAND CORNER MONUMENTATION

History of original corner establishment:

THIS CORNER WAS SET IN 1978 BY
L.S. 1068

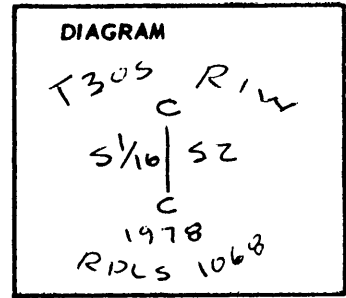


Description of corner evidence found:

FD. 2" IRON PIPE WITH 2 1/2" BRASS CAP EXPOSED 7"
IN SMALL ROCK MOUND.

Description of monument and accessories I established to perpetuate the original location of this corner

I MARKED,

A 9" CEDAR BT WHICH BEARS N 68 1/2° E 30.7' SCRIBED C S 1/16 S 2 BT.
A 7" FIR BT WHICH BEARS S 37° W 27.8' SCRIBED C S 1/16 S 2 BT.

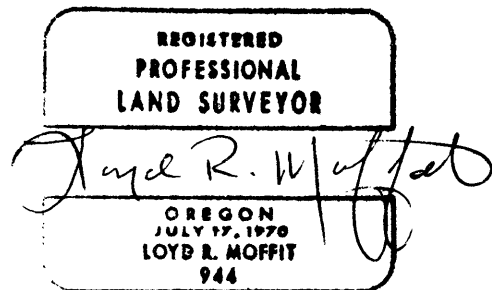

717 W. 10 TH ST
MEDFORD, OR

Office of COUNTY SURVEYOR County of DOUGLAS
 State of OREGON, I hereby certify that the within instrument was filed in this office
 for record on the 6 day of January 1986
Fritz Ingram by Virginia S. Angen
 (COUNTY OFFICIAL) (DEPUTY)