



RENEWAL

Monument Set (Procedure and Description)

I.P. STRAIGHTENED AND RETURNED TO PLUMP POSITION. I.P./BC PROTRUDES 3 IN. ABOVE GROUND.


Monument Detail

N/A

New Accessories

8" DIA. D. FIR DOUBLE BLAZED SCRIBED" 1/4 S36 CSBT" BEARS N 82 1/2° E 24 2 FT.

Sketch of Monument, Accessories, and General Area

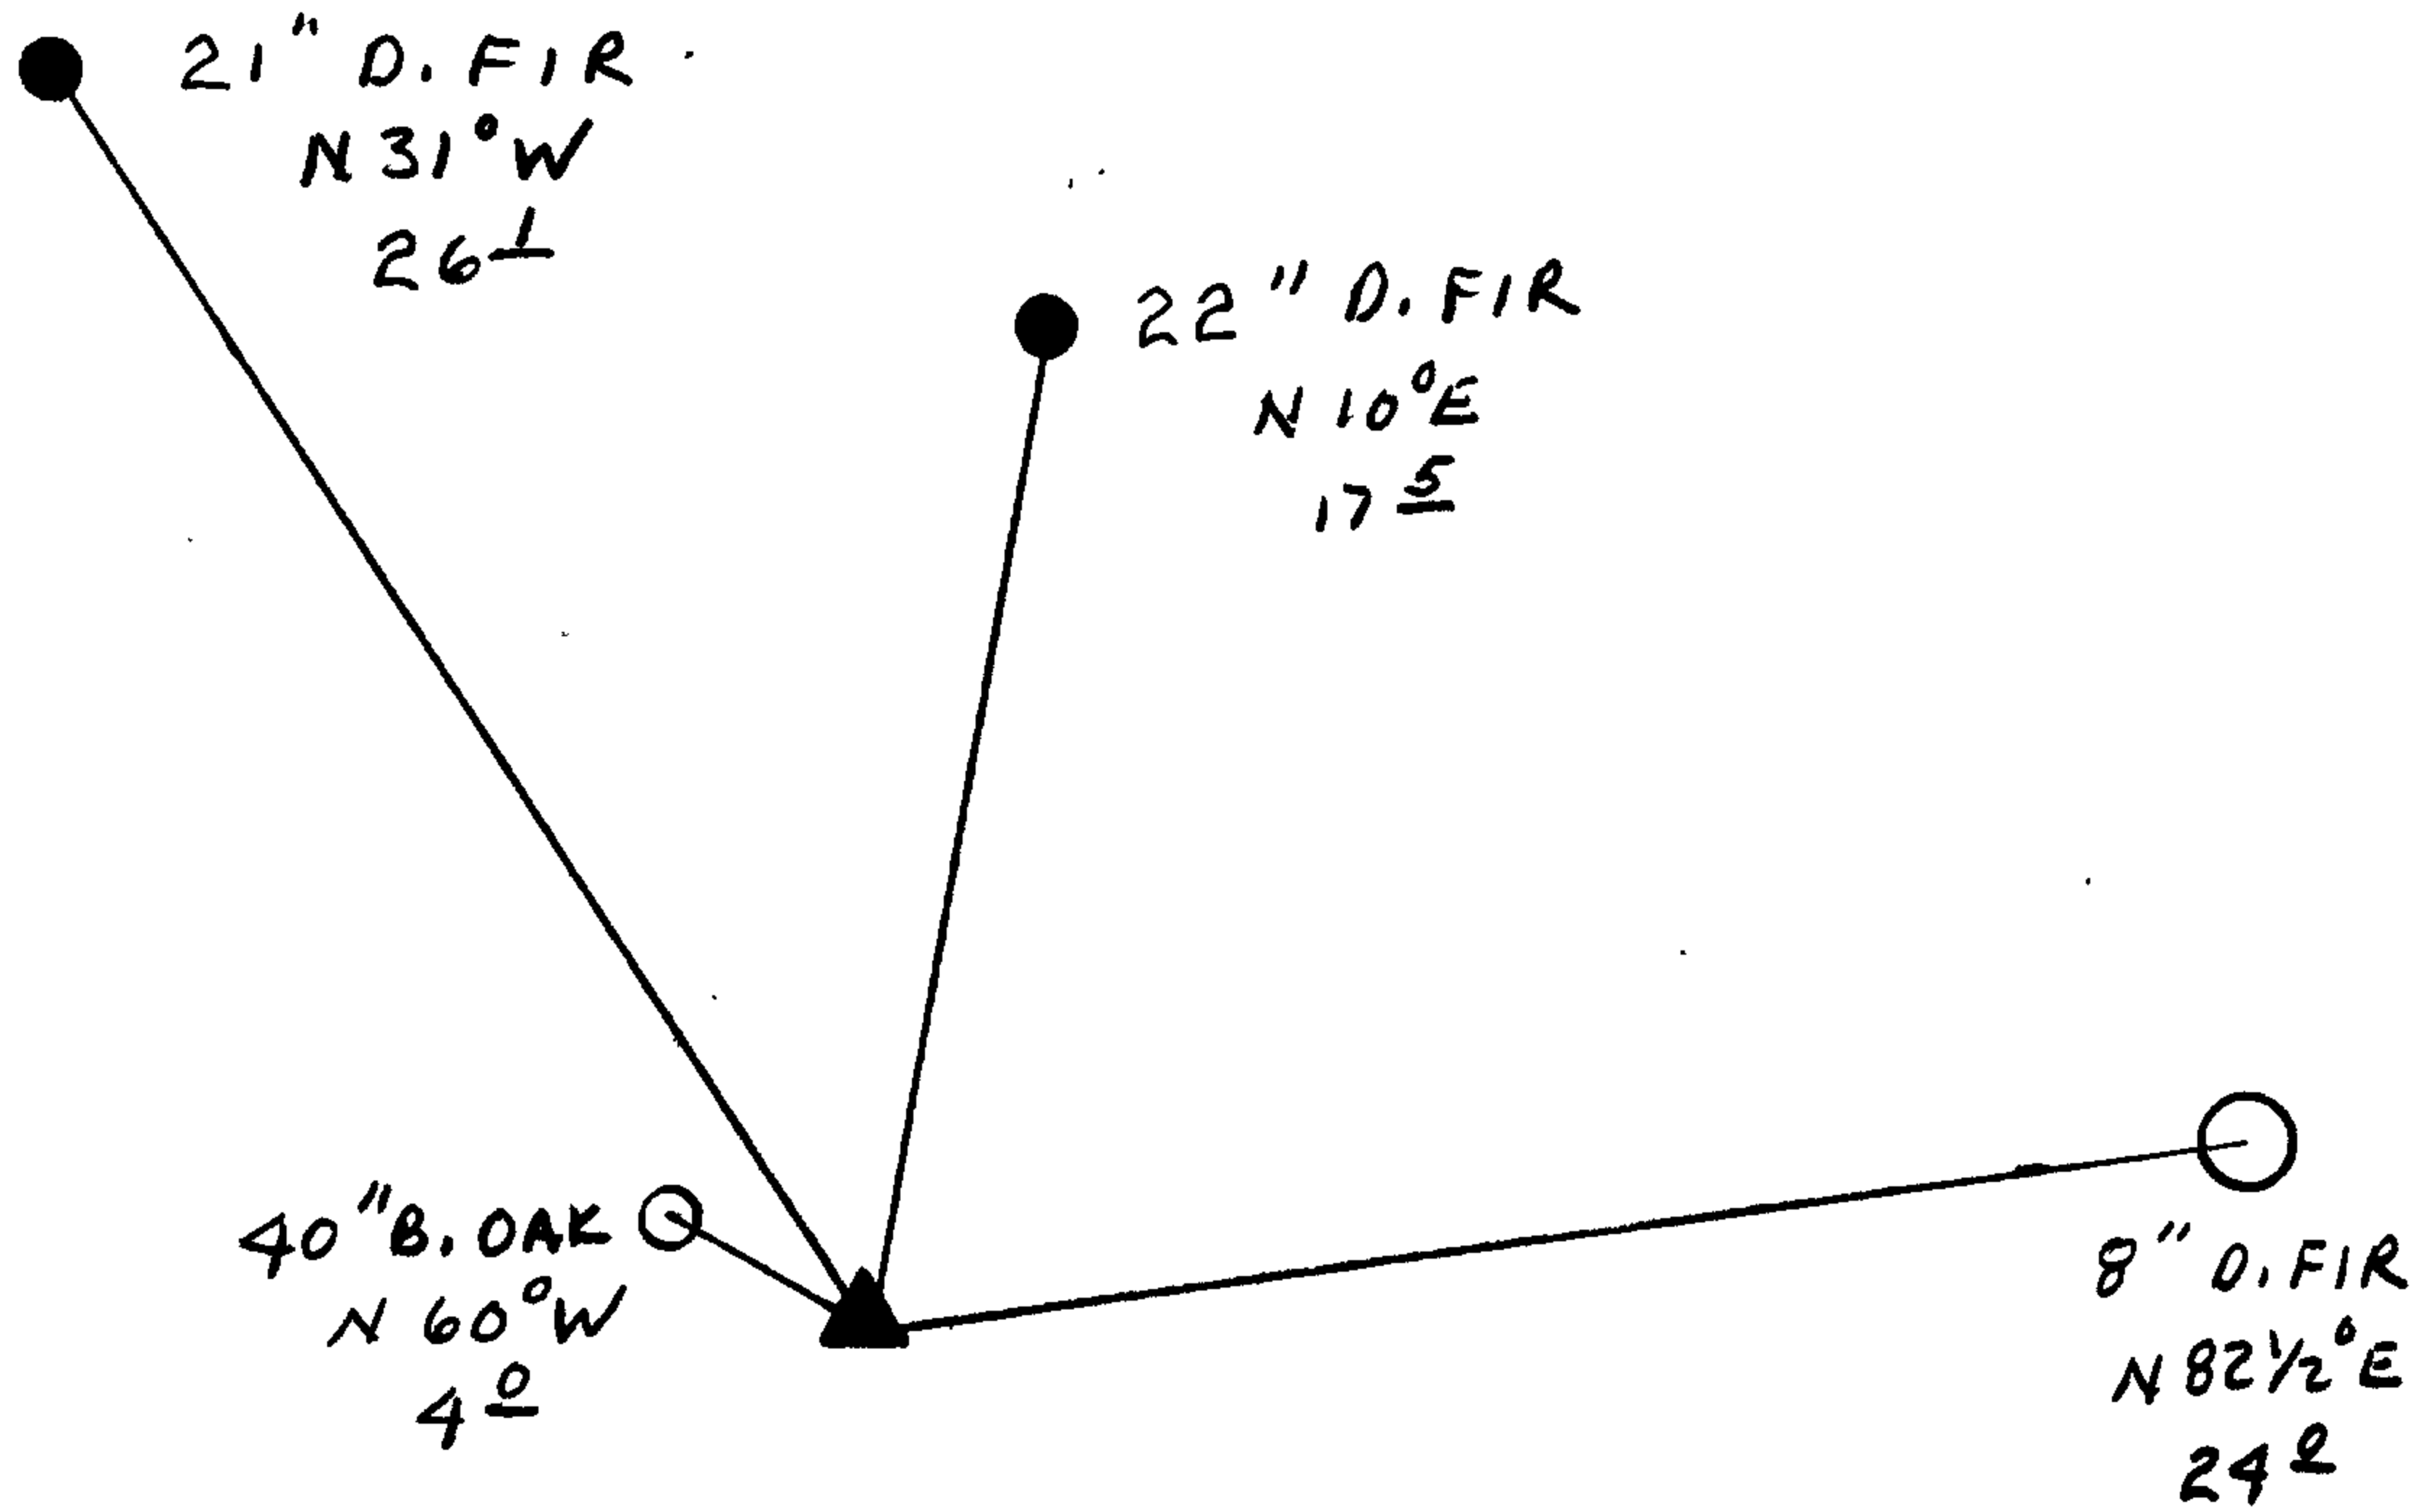

- ▲ BC/I.P. PER REN #67
- ORIG. BT
- BT'S PER REN #67
- NEW BT

Location & Comments

Comp. Declin. 18 1/2° E  
 Agency DCSO  
 Party Chief RANDALL W. SMITH  
 Notekeeper Randall W. Smith  
 Witnesses STEPHEN J. FLAUSE

Address

Surveyor's Seal

REGISTERED  
 PROFESSIONAL  
 LAND SURVEYOR

*Larry E. Monrean*

OREGON  
 JULY 13, 1979  
 LARRY E. MONREAN  
 #1830