

GOVERNMENT CORNER RESTORATION FORM

Township 255 Range 1E Sec. 5 County DOUGLAS

State OR Date 1/13/86 No. _____

Corner Designation

56 | 55
57 | 58

- _____ Condition Report Only
- _____ Not Found
- Renewed
- _____ Unrecorded
- _____ Surveyed In
- _____ Referenced Out

Previous Renewals NONE

MONUMENT DETAIL

Monument(s) Found: (Condition and Source)

A US GENERAL LAND OFFICE 3 IN DIA.
BC ON A 12 IN DIA I.P. LEANING NORTH
PROTRUDING 29 IN ABOVE GROUND. (ORIG.)

U.S. GENERAL LAND OFFICE SURVEY

56 | 55
57 | 58

1927

Accessories Found:

ORIG. BT'S CHECKED FROM PLUMB POS. OF MON.
10" NOW 14" DIA. WESTERN WHITE PINE WITH A PARTIALLY HEALED
SINGLE BLAZE "T255 R1E 5/BT" BEARS N52°E, 11.2 FT
(REC. N55°E 11.2 FT).

10" NOW 10" DIA WESTERN WHITE PINE WITH A PARTIALLY HEALED
SINGLE BLAZE "T255 R1E S 8/BT" BEARS S45°E 15.8 FT
(REC. S43°E 15.8 FT).

12" NOW 20" DIA. HEMLOCK WITH A PARTIALLY HEALED SINGLE
BLAZE ILLEGIBLE SCRIBING VISIBLE BEARS N29°W 13.2 FT.
AGREES WITH REC. (ORIG. BT CALLED A SPRUCE)

12" NOW 13" DIA. DEAD STILL STANDING WESTERN WHITE PINE
WITH A PARTIALLY HEALED SINGLE BLAZE "T255 R1E S7/BT"
BEARS S22°W, 75.5 FT. AGREES WITH REC.


RENEWAL

Monument Set (Procedure and Description)

PLUMB POSITION OF BC/I.P. REMONUMENTED AS
 CORNER LOCATION DISTANCES AND BEARINGS
 FIT WELL WITH RECORD INFORMATION.

BC/I.P. RETURNED TO PLUMB POSITION AND
 A 3 FT DIA BY 2 FT HIGH MOUND OF
 STONE PLACED AROUND I.P.


Monument Detail

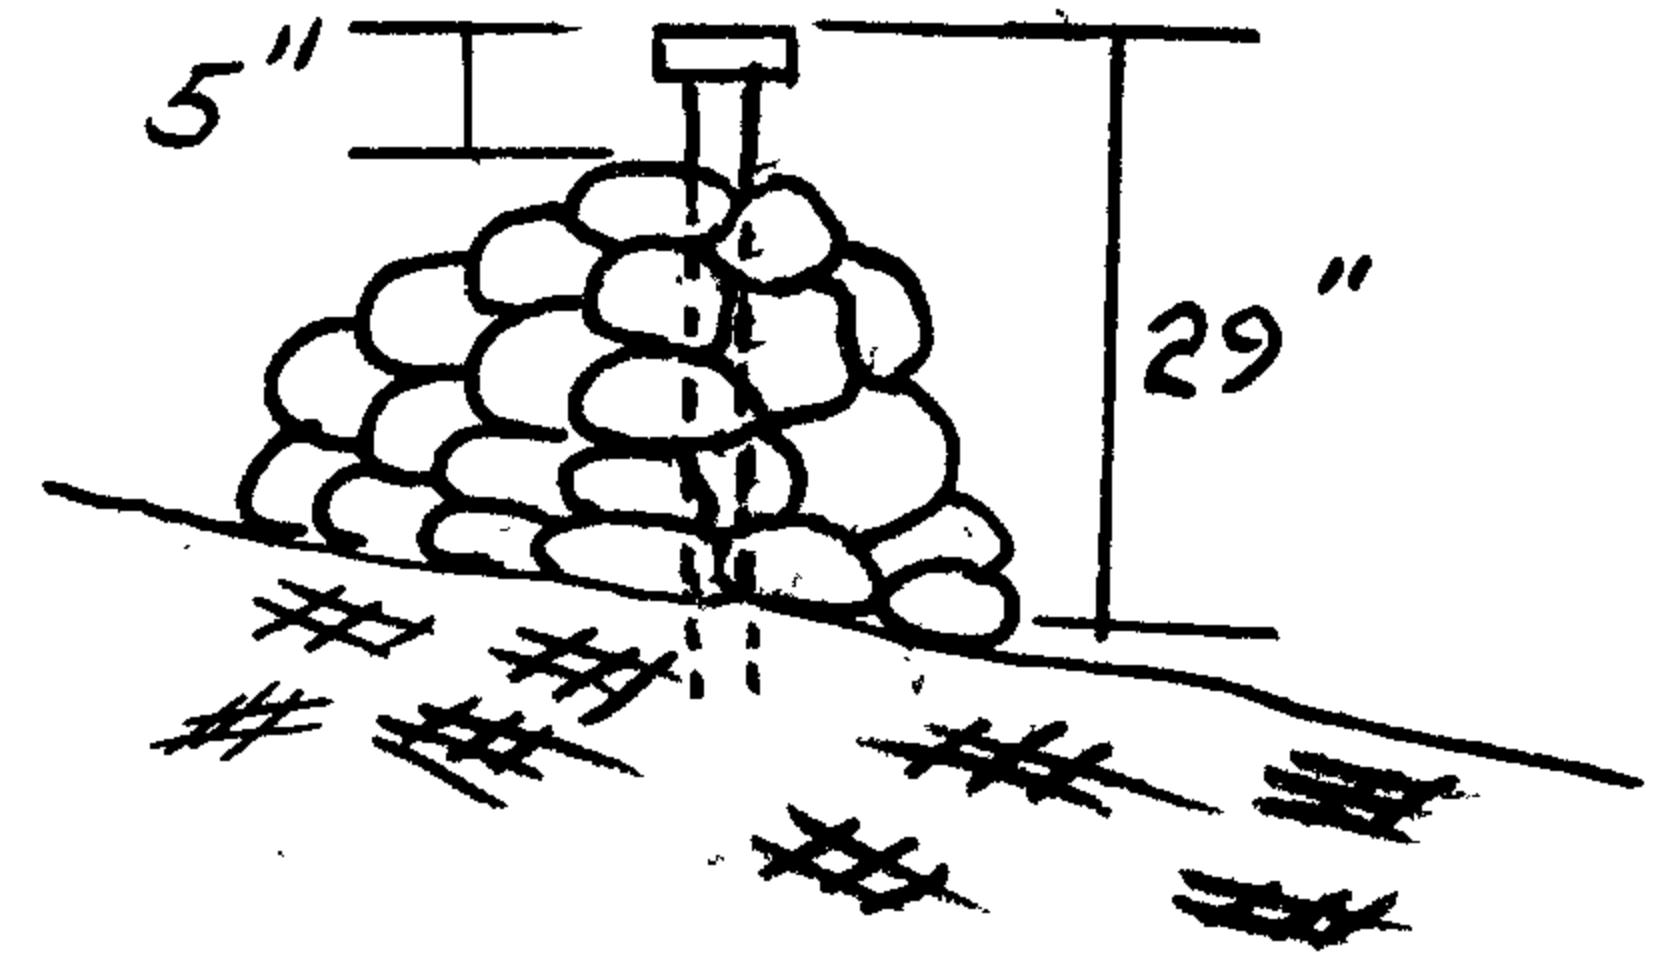

New Accessories

8" DIA. WESTERN WHITE PINE DOUBLE BLAZED AND SCRIBED "T255 R1E S7CS BT"
 BEARS S19°W, 16.0 FT.

Sketch of Monument, Accessories, and General Area

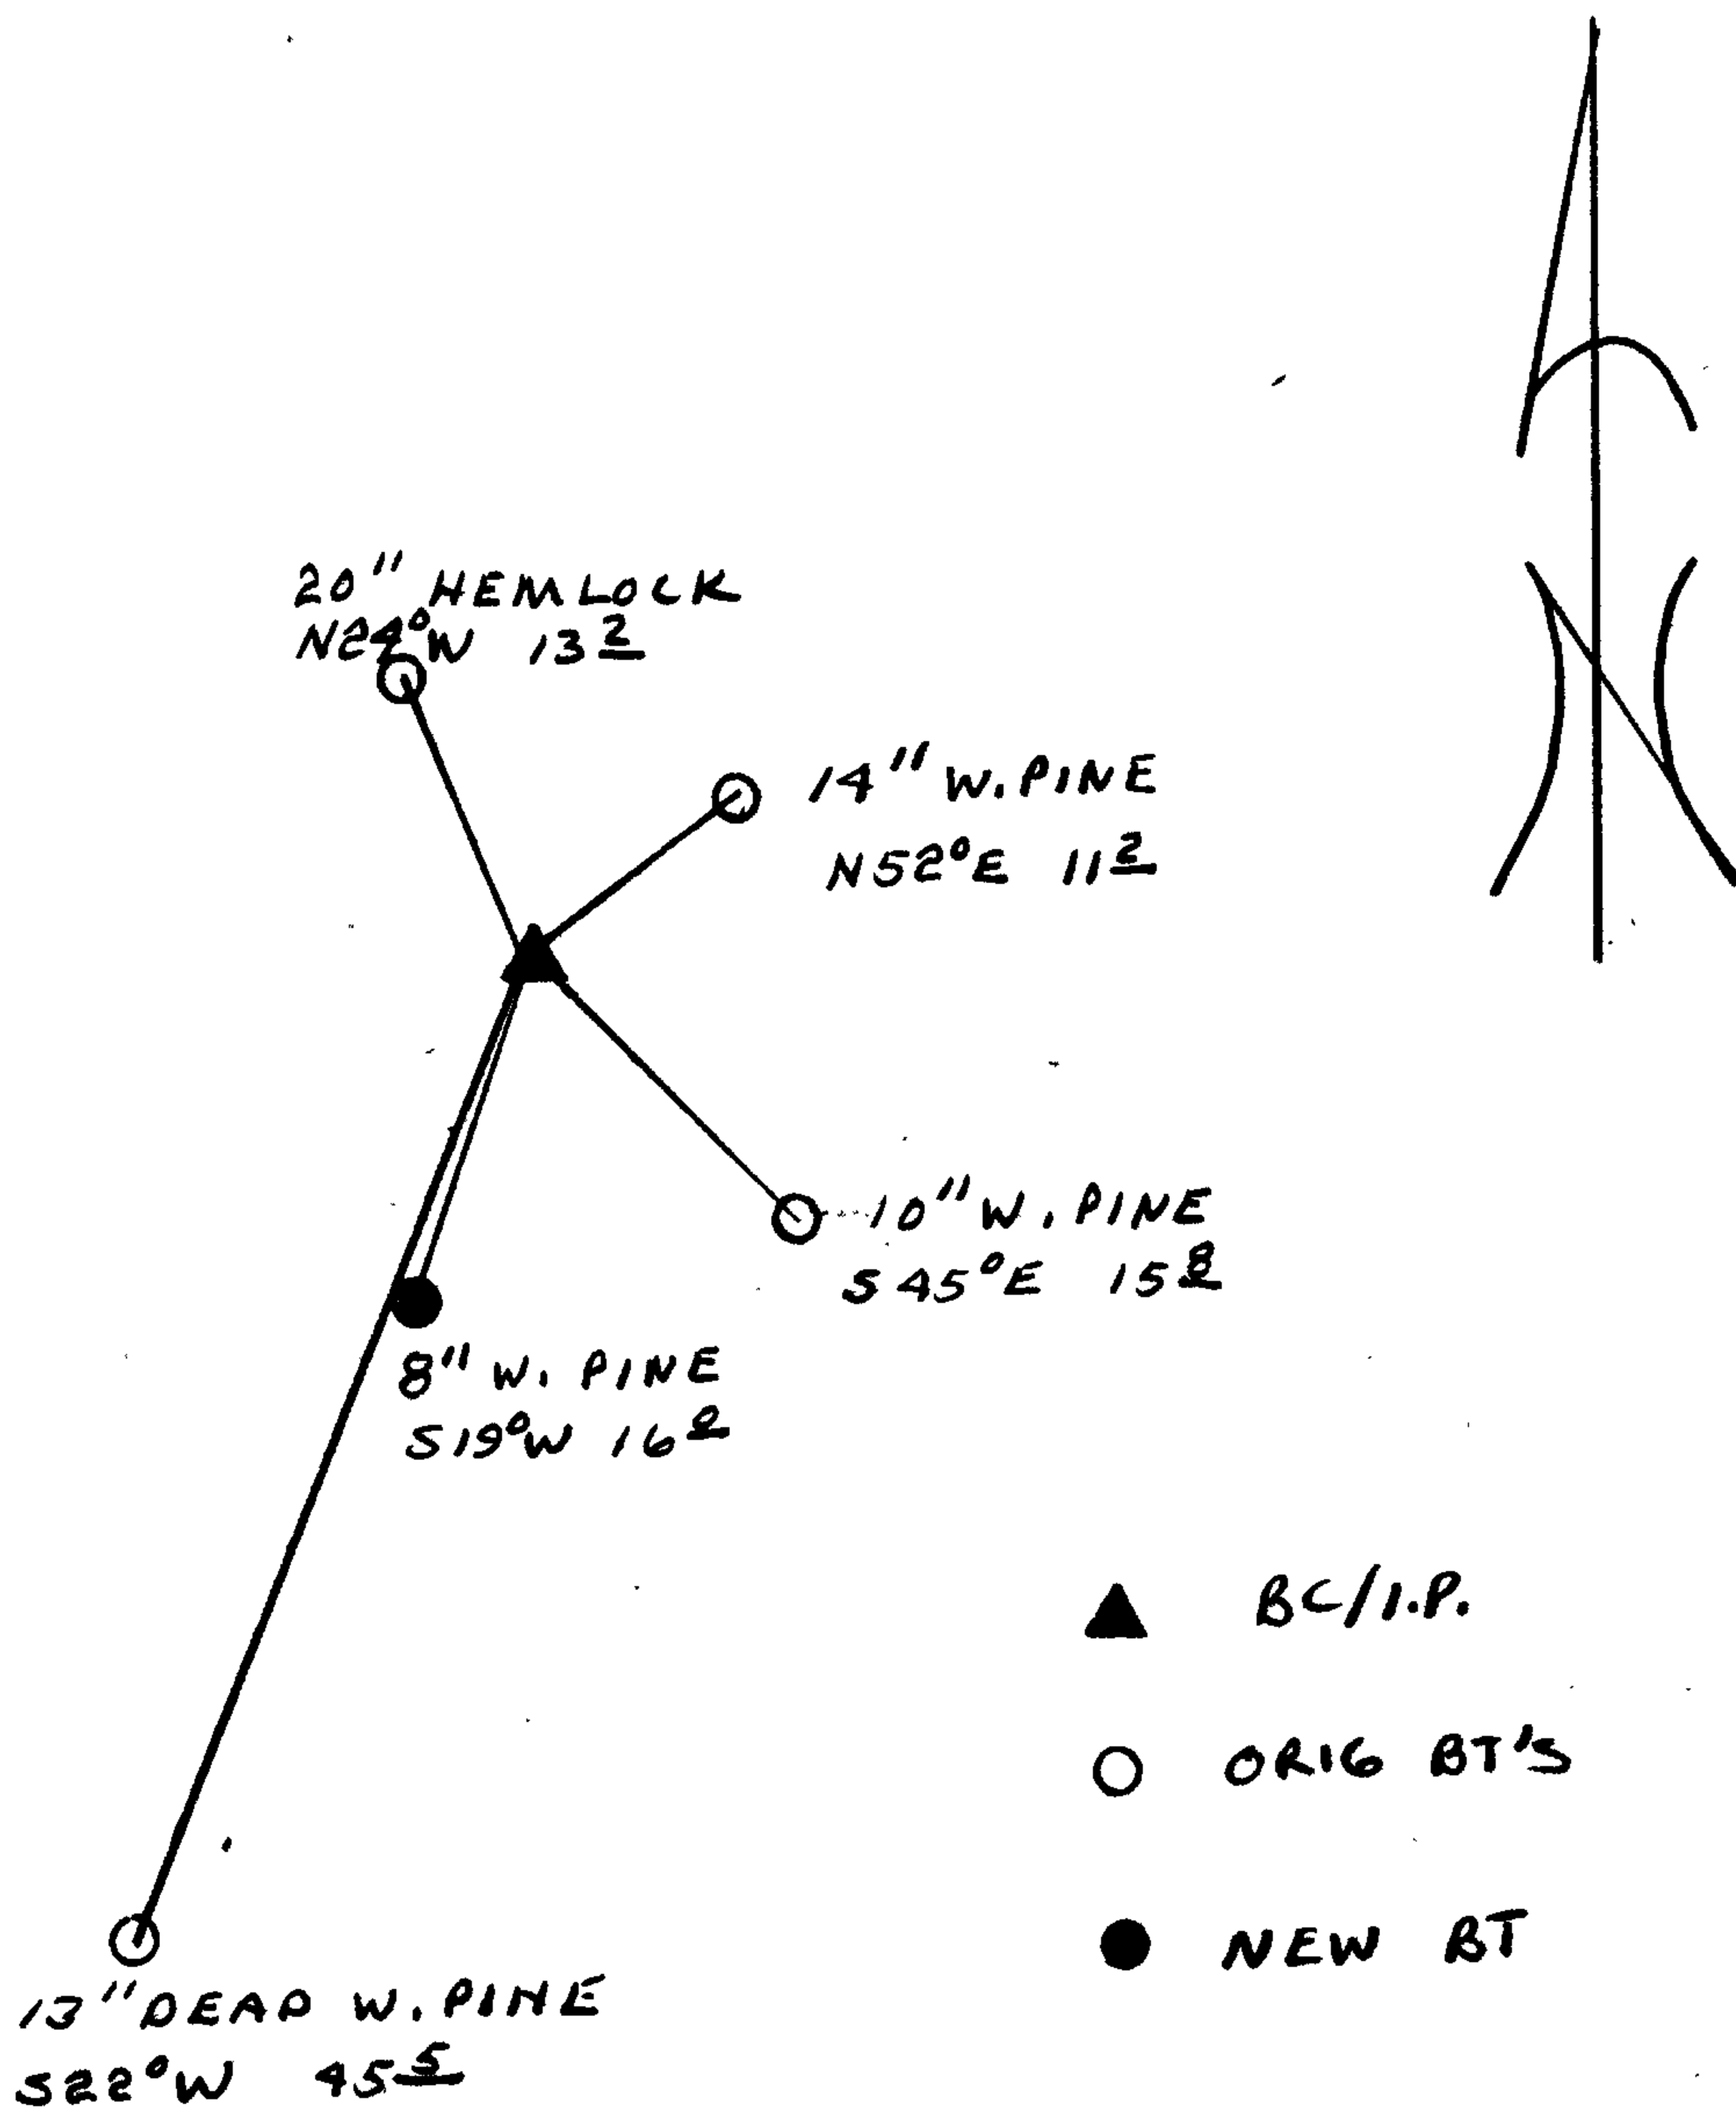

Location & Comments

CORNER LIES ON A GENTLE
 SE SLOPE.

Comp. Declin. 18 1/2° E
 Agency OCSO
 Party Chief RANDALL W. SMITH
 Notekeeper Randall W. Smith
 Witnesses STEPHEN J FLAUSE

Surveyor's Seal

REGISTERED
 PROFESSIONAL
 LAND SURVEYOR

Larry E. Monrean

OREGON
 JULY 13, 1979
 LARRY E. MONREAN
 #1830