

RENEWAL

Monument Set (Procedure and Description)

Monument Detail


U.S. GENERAL LAND OFFICE SURVEY
 BC/I.P. RETURNED TO PLUMB POSITION
 AND A 2 FT DIA. MOUND OF STONE
 14 IN. HIGH PLACED AROUND I.P.
 BC/I.P. PROTRUDES 9 IN. ABOVE MOUND
 OF STONE.

PLUMB POSITION OF BC/I.P. ^{REMINDED} ~~ACCEPTED~~ AS
 CORNER LOCATION. THE NW AND SE BT'S
 DISTANCES APPEAR TO BE INTERCHANGED,
 IF THAT PROBLEM IS CORRECTED THE BEARINGS
 AND DISTANCE TO ORIG. BEARING TREES
 AGREE CLOSELY WITH RECORD INFORMATION.

New Accessories

14" DIA. D. FIR DOUBLE BLAZED SCRIBED "TSS RIE SRB CS BT"
 BEARS N64 1/2° E, 51.3 FT.

Sketch of Monument, Accessories, and General Area

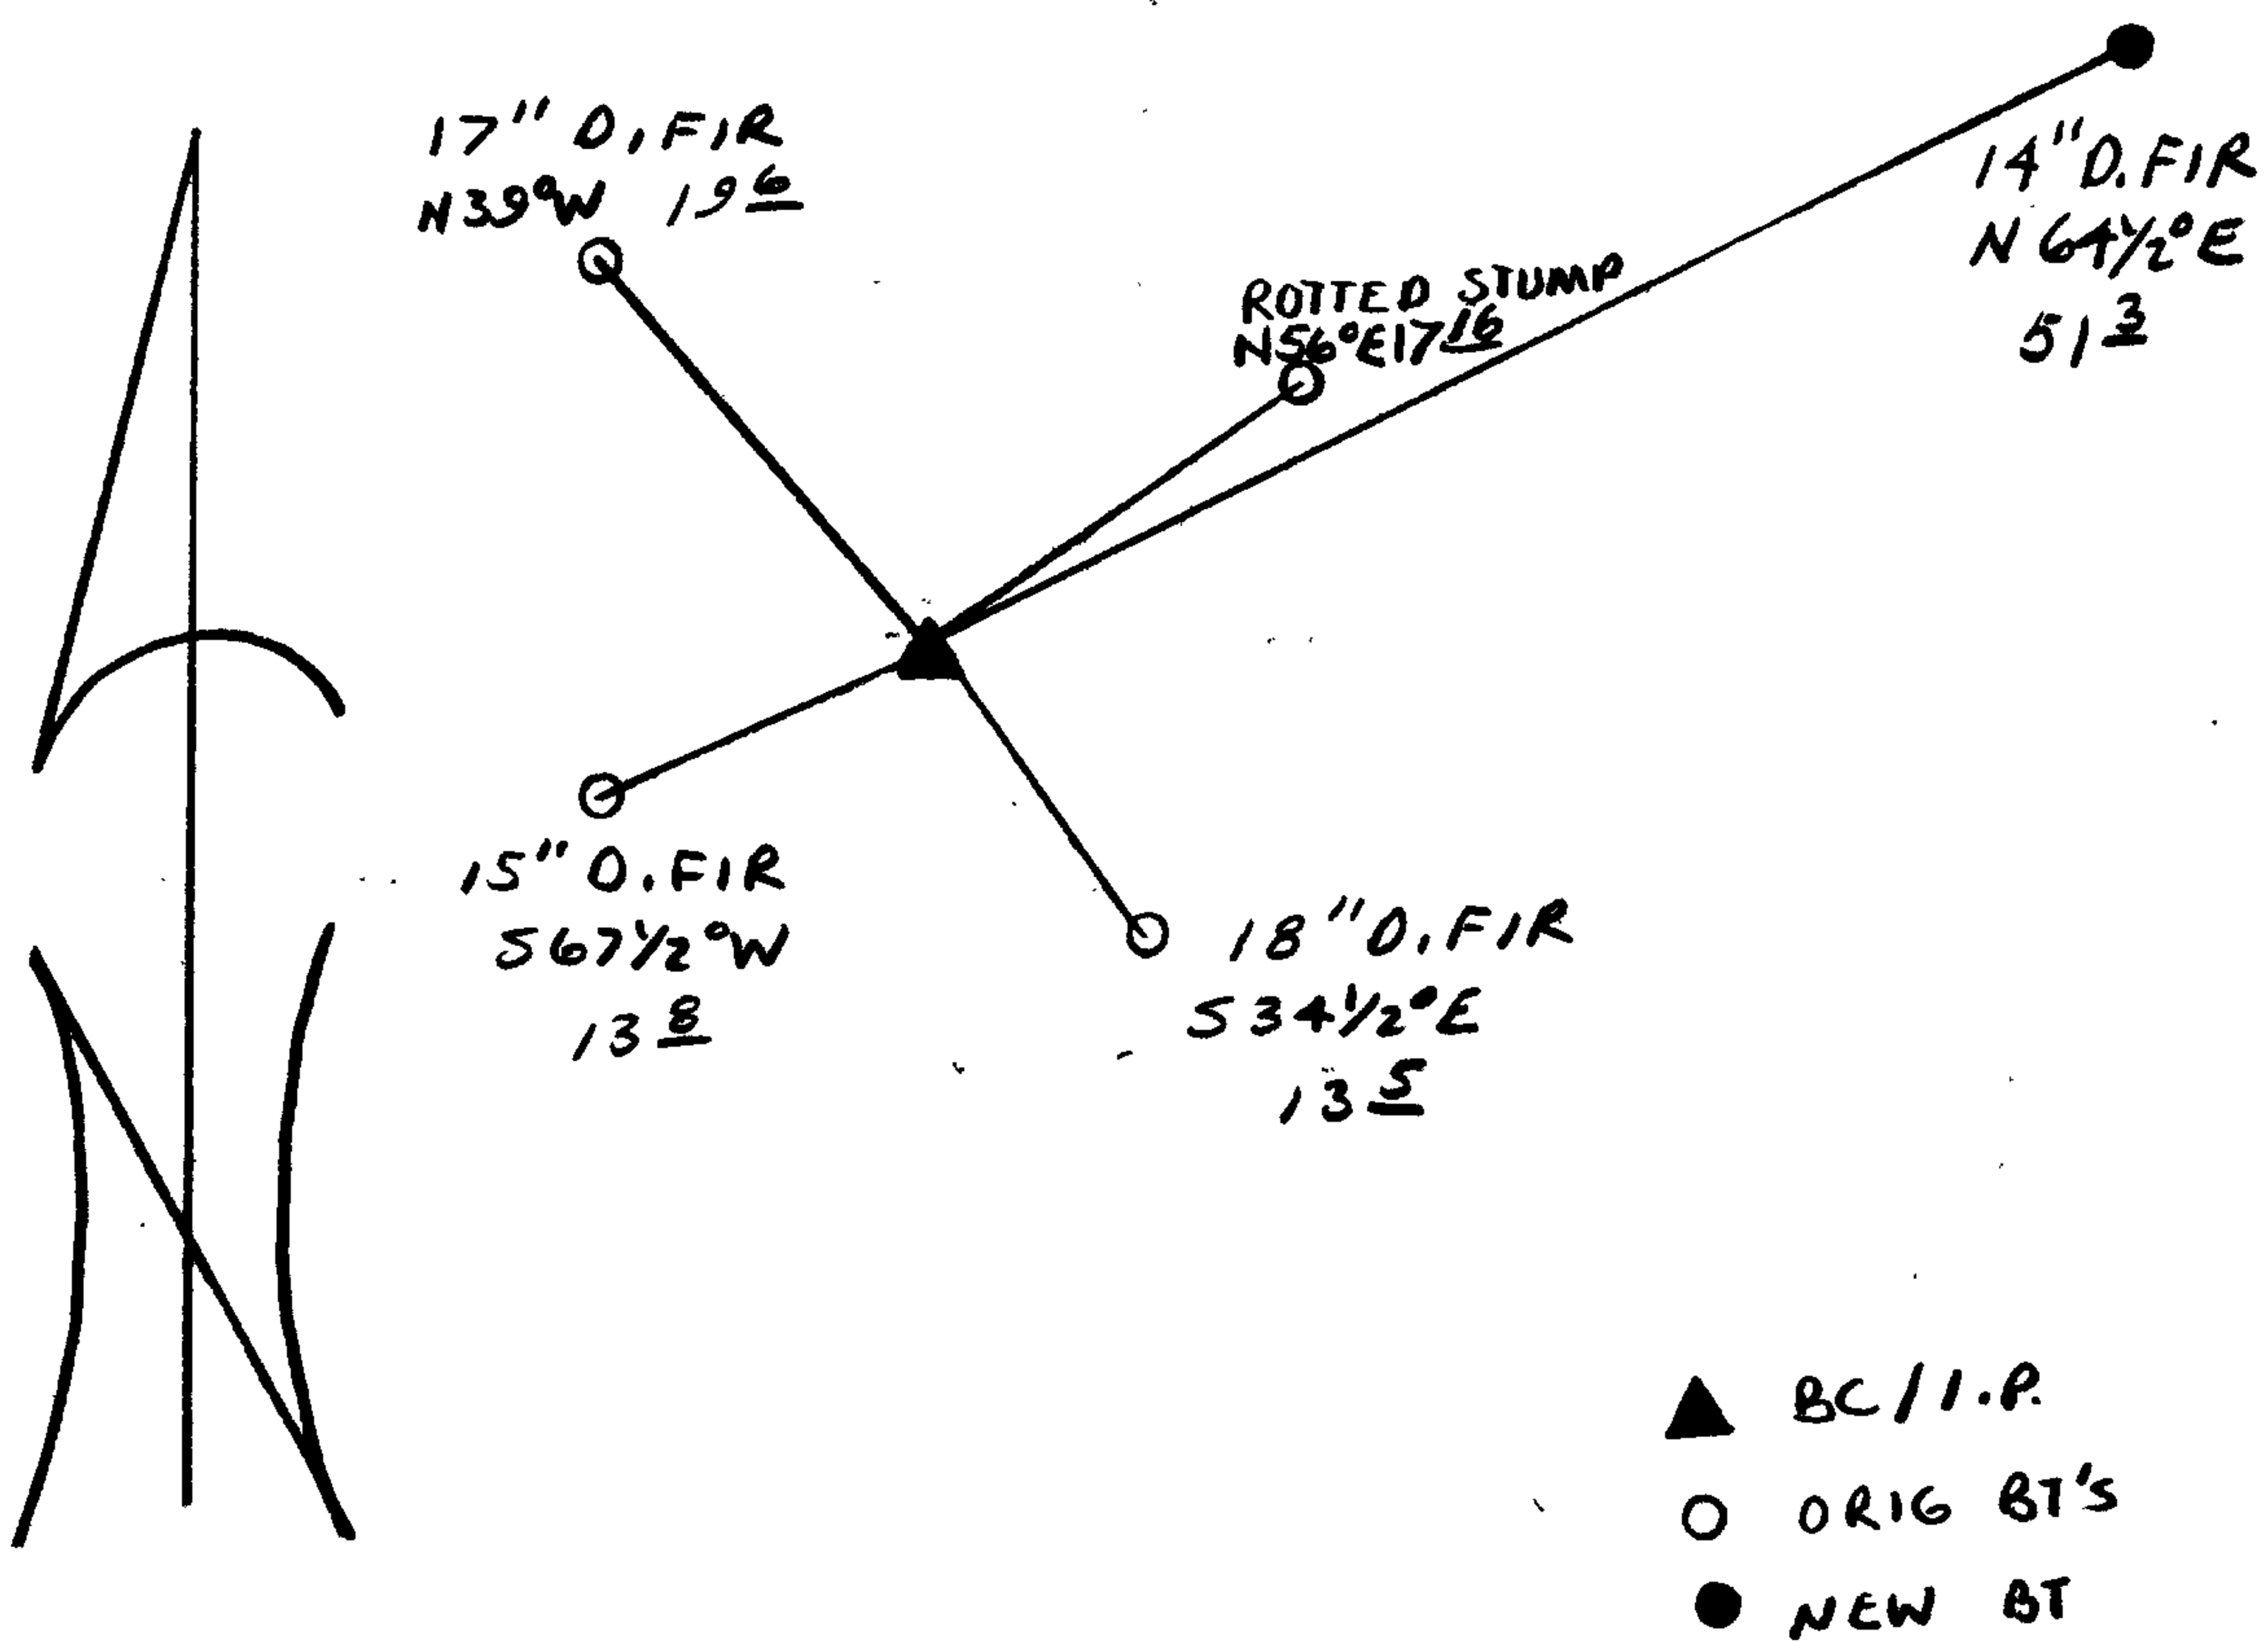

Location & Comments

CORNER LIES ON LEVEL GROUND

Comp. Declin. 18 1/2° E
 Agency DCSO
 Party Chief RANDALL W SMITH
 Notekeeper STEPHEN J FLAUSE
 Witnesses Stephen John Flause

Surveyor's Seal

REGISTERED
 PROFESSIONAL
 LAND SURVEYOR

Larry E. Monrean

OREGON
 JULY 13, 1979
 LARRY E. MONREAN
 #1830