


CERTIFIED RECORD OF LAND CORNER MONUMENTATION

History of original corner establishment:

Corner established by Otto L. Draper in 1928:

Set an iron post, 3 ft. long, 1 in. diam., 27 ins. in the ground, for the 1/4 sec. cor. of sec. 6 only, with brass cap marked, | 1/4 S6
1928

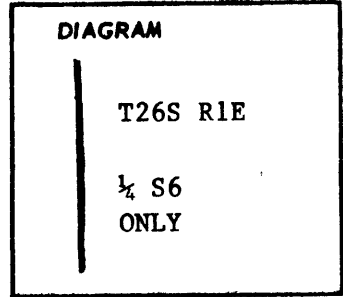

From which:

A fir, 30 ins. diam., bears N 25°E, 43 lks, dist. marked "1/4 S6 BT".

A fir, 18 ins. diam., bears S 18°E, 21 lks. dist., marked "1/4 S6 BT".

FILED

NOV 10 1986

COUNTY SURVEYOR
DOUGLAS COUNTY, ORE.

Description of corner evidence found:

The original 1" diameter iron pipe is firmly set, projecting 10" above the ground.

The attached brass cap is marked: | 1/4 S6
1928

Vol 22 CS Rec
Pg 753

From which the remains of the original bearing trees:

A roothole bears N 25°E , 28.4 ft., with decayed log along side, size indeterminate, with no marks visible.

A decayed stump, size indeterminate, bears S 18°E, 13.9 ft. with no marks visible.

Description of monument and accessories established to perpetuate the original location of this corner

From the original iron post, I mark 2 new bearing trees:

A 10" W.Fir bears N 73°E, 25.5 ft, scribed "1/4 S6 BT" on a single blaze with a 3/4" brass washer, stamped "LS 1181", nailed flush to base of blaze.

A 5" W.Fir bears S 18°E, 16.6 ft, scribed "XBT" on a single blaze with a 3/4" brass washer, stamped "LS 1181", nailed flush to base of blaze.

I set a 6 ft. long aluminum post, driven 2 ft. in the ground, as a guard post, bears North, 2.0 ft. with Forest Service sign #54-4 attached.

Magnetic declination is 18° East.

To reach corner drive 1.4 miles up forest road #4712-010, thence approximately 400 ft., West.

Witness: Leonard Herzstein

REGISTERED
PROFESSIONAL
LAND SURVEYOR
Maurice E. Farr
OREGON
SEPT. 23, 1977
MAURICE E. FARR
1181

Office of Surveyor..... County of Douglas.....
State of Oregon....., I hereby certify that the within instrument was filed in this office
for record on the 10 day of November 1986.
Fritz Ingram..... by *Virginia A. Saugen*
(COUNTY OFFICIAL) (DEPUTY)

#122 T26-1W 4
#14 T26-1E 4

C