

**CERTIFIED RECORD OF LAND CORNER MONUMENTATION**

**History of original corner establishment:**

First established by Glen Baughman, L.S. 536, in 1974  
(see File No. M52-77).


Set: 2" iron pipe.

Scribed: 12" Cedar, "C $\frac{1}{4}$  S12 BT", S38°W, 4.4 ft.

8" Hemlock, "C $\frac{1}{4}$  S12 BT", N23°E, 15.7 ft.

Found: 3/4" iron rod, set by U.S. Plywood in 1956, is  
South, 26.76 ft. and East, 0.85 ft.

**FIT FT)**

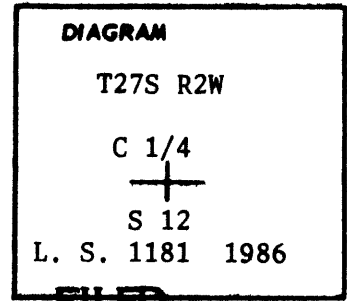

*JH*

DEC 8 1986

**COUNTY SURVEYOR  
DOUGLAS COUNTY, ORE.**

**Description of corner evidence found:** November 5, 1986. I found a  
2" outside diameter iron pipe, firmly set, projecting 8" above the ground.

From which bearing trees by Baughman in 1974:

A 9" Hemlock, N.23°E., 15.7 ft., with a healed blaze.

A 12" Red Cedar, S.38°W., 4.4 ft., with scribe marks "C $\frac{1}{4}$  S12 BT" visible on  
a partially healed blaze.

And an unrecorded rebar set by U.S. Plywood Corp. in 1956: A 5/8" rebar firm-  
ly set, projecting 15" above the ground, bears S. 02°E., 26.8 ft.

A steel fence post bears South, 5.1 ft. with Forest Service signs #54-2 and  
#54-9 as a guard post.

**Description of monument and accessories I established to perpetuate the  
original location of this corner** November 5, 1986

I remove Baughman's iron pipe, which is 36" long, and in its place I set a  
2"x32" long iron pipe, set 24" in the ground, with a brass cap marked as  
shown above.

I bury Baughman's iron pipe alongside. I raise a 2 ft. diameter mound of  
stone flush to the brass cap.

I find the magnetic declination to be 19°E.

Witnesses: Leonard Herzstein and Randy Lopez.



Office of Surveyor..... County of Douglas  
 State of Oregon....., I hereby certify that the within instrument was filed in this office  
 for record on the 8th day of December 1986  
Fritz Ingram..... by Virginia A. Saugen  
 (COUNTY OFFICIAL) (DEPUTY)

#248 X

U