

COUNTY SURVEYORS FILE DATA  
NOT REMOVE FROM OFFICE

Scale  
one inch = 200 ft


# MAP

#11

Showing proposed vacation of  
MILL STREET. also that portion of WEST  
RAILROAD ST, 8TH ST, 9TH ST and 10TH  
ST. lying north of a line drawn thru the  
center of Blocks 9, 10, and 11

RAINBOW ADDITION to REEDSPORT  
Douglas County Ore.

Petition of WINCHESTER BAY LUMBER CO  
Owners.  
Portions to be vacated are shaded.

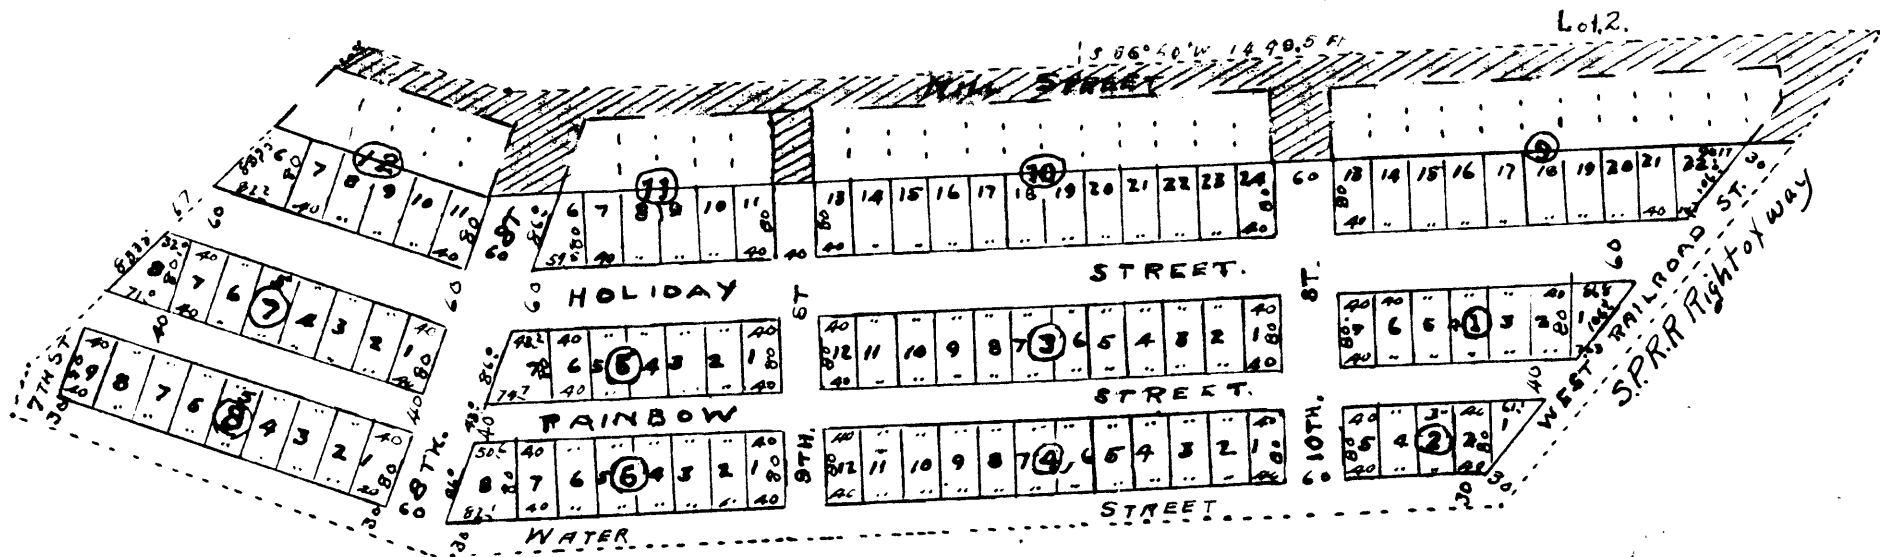

FILED

MAR 12 1986

COUNTY SURVEYOR  
DOUGLAS COUNTY, ORE.

*D. F. Buckingham*

19

C.S. File No. 62/35-11

Sec. 34 & 35 T21-12

B-225

B-2