

GOVERNMENT CORNER RESTORATION FORM

Township 25S Range 4W Sec. 7 County DOUGLAS

State OR Date 4/14/87 No. _____

Corner Designation

NNW
DLC 37

- _____ Condition Report Only
- _____ Not Found
- Renewed
- _____ Unrecorded
- _____ Surveyed In
- _____ Referenced Out

Previous Renewals NONE

Monument(s) Found: (Condition and Source)

A 3"X10"X13" STONE BURIED WITH TOP
PROTRUDING 3 IN. ABOVE GROUND.
(POSSIBLE ORIG. MONUMENT).

MONUMENT DETAIL

N/A

Accessories Found:

POSSIBLE ORIG. BT

20" NDW 21" DIA. 15 FT HIGH SNAG, PREVIOUSLY OPENED, WE FIND OLDER AXE MARKS
AND SMALL PIECES OF BLAZE WITH NO SCRIBING. BEARS S75°E, 25.1 FT
(REC. S71°E, 73.9 FT DISTANCE A POSSIBLE FACE MEASUREMENT).

#173+

RENEWAL

Monument Set (Procedure and Description)


WE ACCEPT THE POSITION OF STONE AS THE MOST PROBABLE LOCATION OF THE ORIG. NNW DLC 37 CORNER, BASED ON THE FOLLOWING OBSERVATIONS. STONE APPEARS TO BE A LOCALLY ACCEPTED CORNER. IT IS THE INTERSECTION POINT OF AN OLD NORTHERLY - SOUTHERLY AND EASTERLY FENCE LINE. STONE WAS TIED IN SURVEY (M49-7) BY VICTOR MCLIND AS THE DLC CORNER. THE ORIGINAL CALL OF CALAPOOYA CREEK TO THE EAST CHECKS OUT WELL. THE POSITION OF STONE FITS WELL WITH OTHER GOVERNMENT CORNERS IN AREA (SECOR DLC #46 AND SECTION CORNER 1/6 12/7). SEE ACCOMPANYING COMPUTATIONS.

SET 2 3/8" DIA BC ON A 1" I.D. X 32" LONG I.P. PROTRUDING 8" ABOVE GROUND, RESET 3" X 10" X 13" STONE ALONG EAST EDGE OF I.P. PROTRUDING 3" ABOVE GROUND.

New Accessories

9" D. FIR DOUBLE BLAZED AND SCRIBED "NNW DLC 37 CS BT" BEARS N 81 3/4° E, 25.9 FT
12" I. CEDAR DOUBLE BLAZED AND SCRIBED "NNW DLC 37 CS BT" BEARS N 51 1/2° W, 31.8 FT
DOUBLE TRUNKED MYRTLE WITH SCRIBING ON EAST 9" TRUNK, DOUBLE BLAZED AND SCRIBED "NNW DLC 37 CS BT" BEARS S 9° E, 47.5 FT TO CENTER OF ROOT CROWN.

Sketch of Monument, Accessories, and General Area

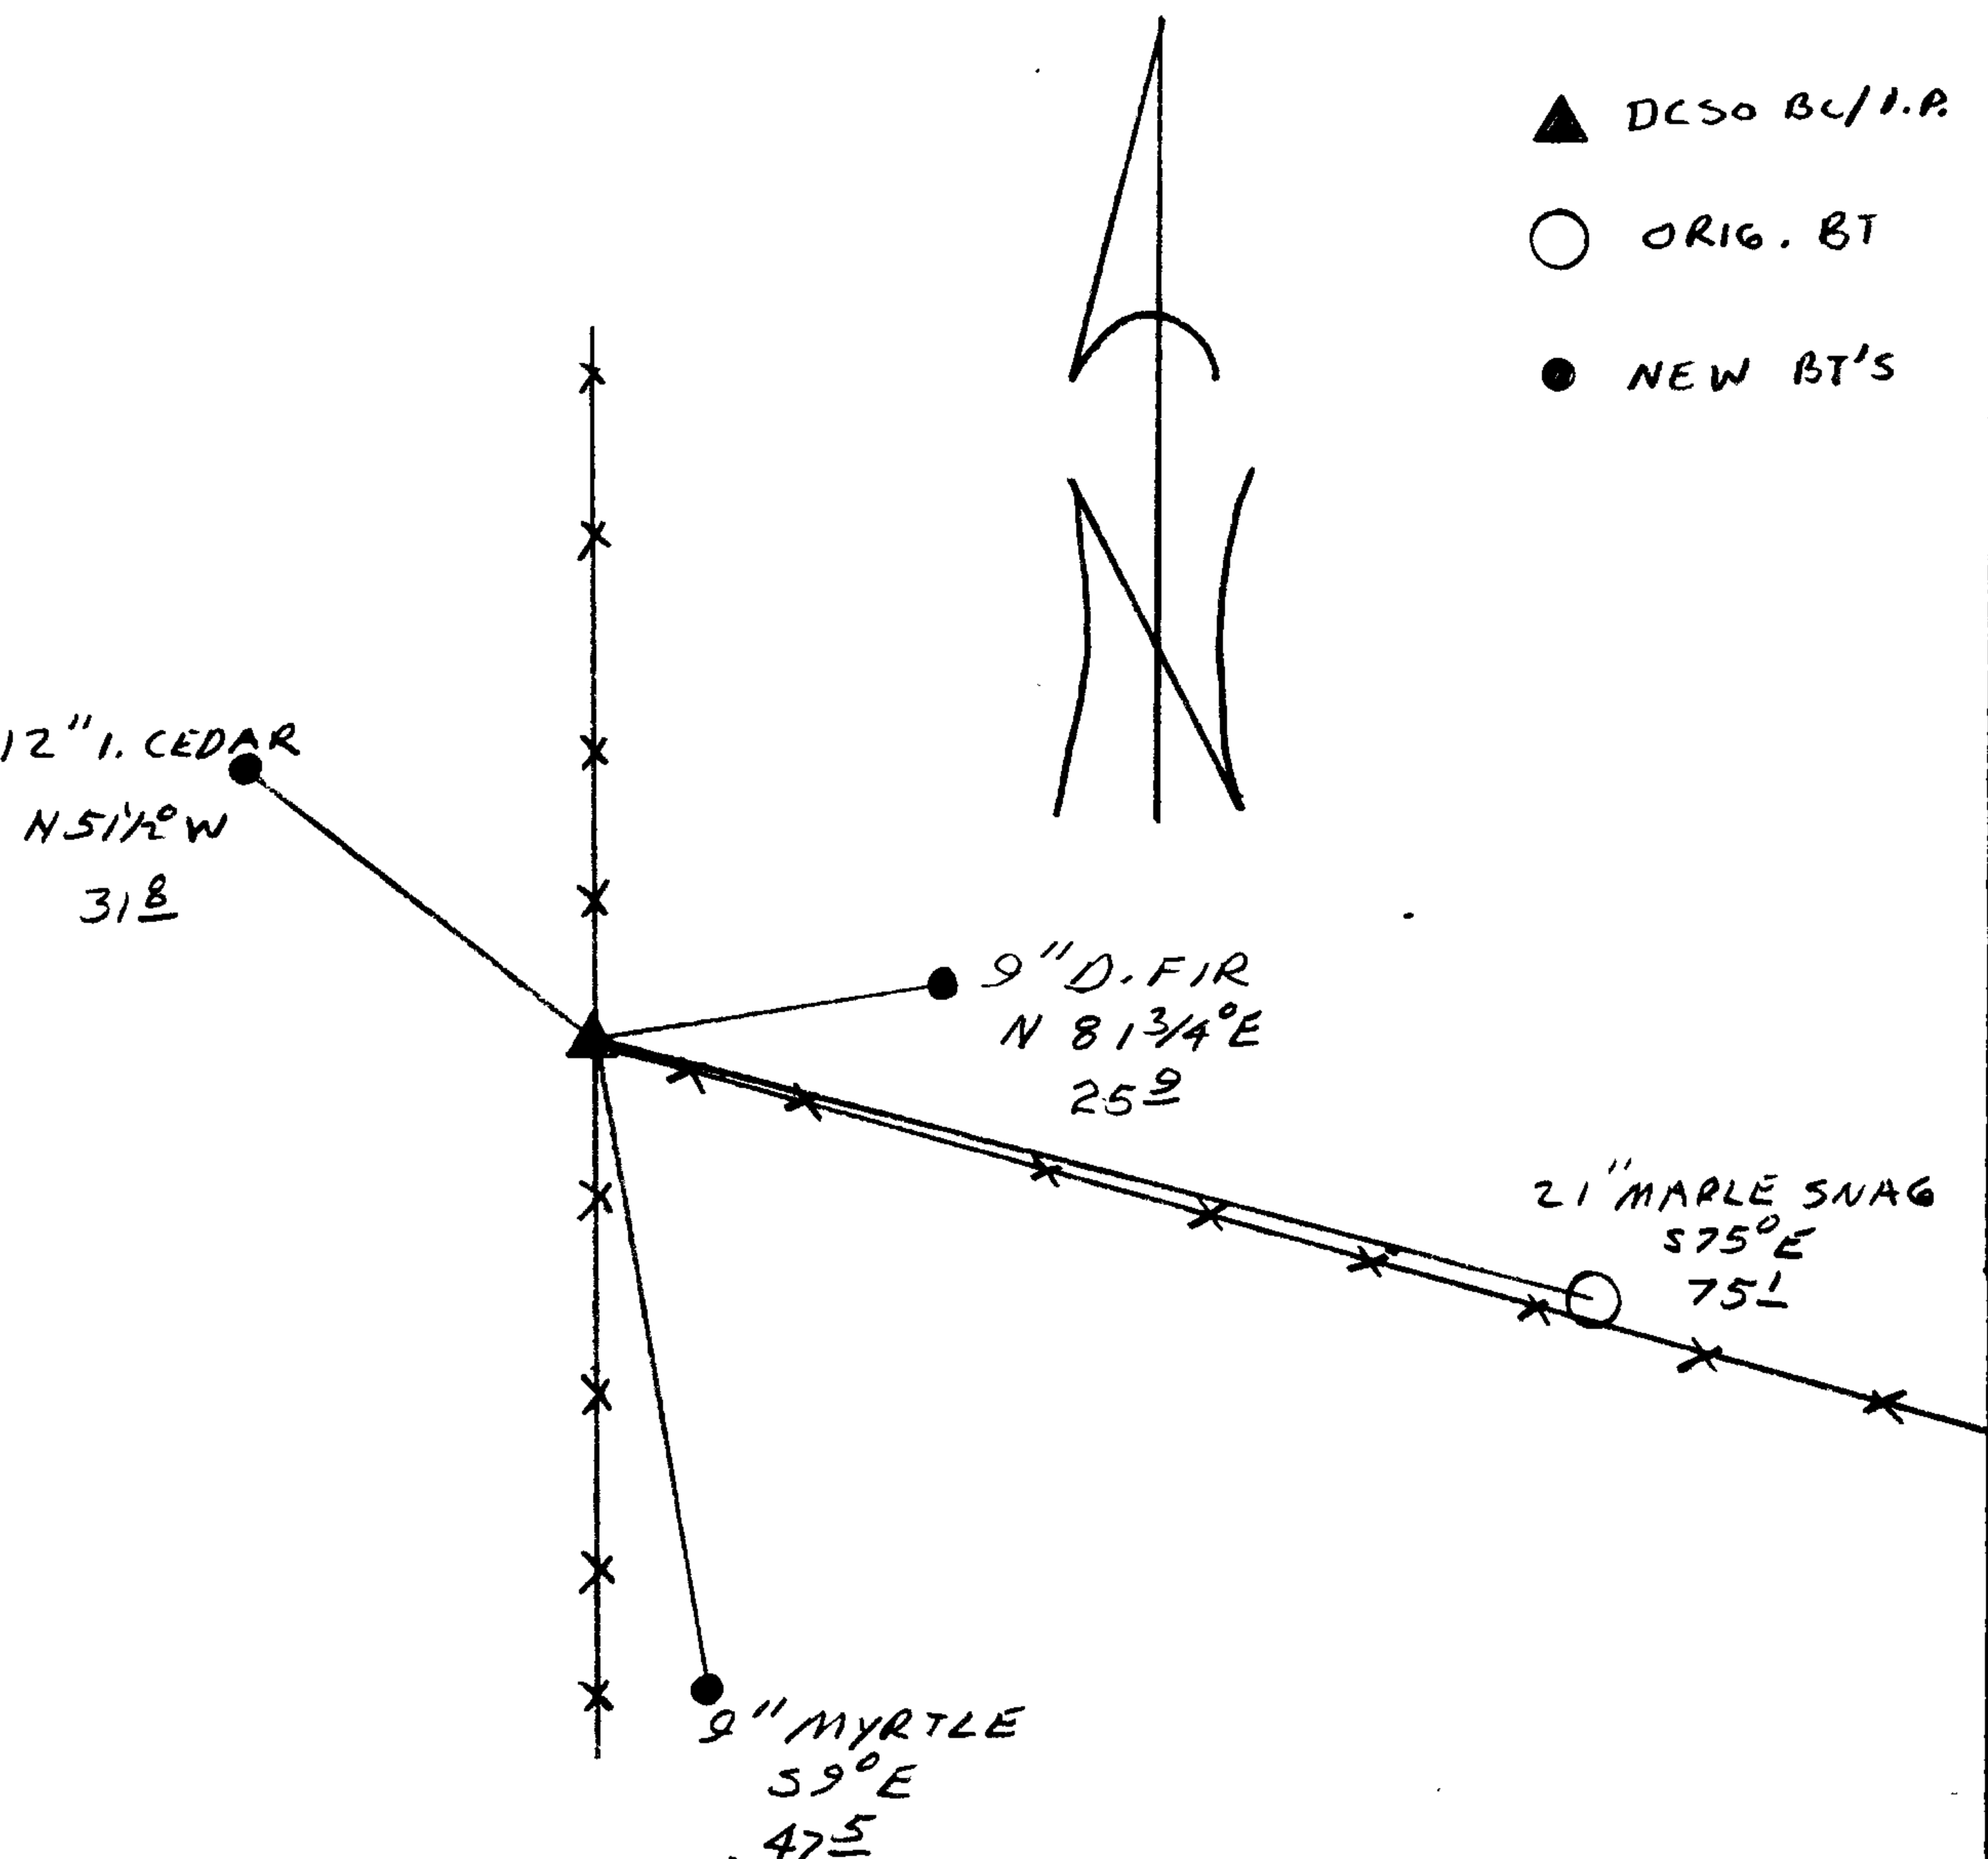

Monument Detail

DOUGLAS COUNTY SURVEYORS
T255
R NNW
4 DLC
W 37
1987
OFFICE

Location & Comments

CORNER LIES APPROX 300 FT NORTH OF FAIROAK COMMUNITY CHURCH AT THE INTERSECTION OF A NORTHERLY - SOUTHERLY AND EASTERLY FENCE LINE. CORNER LIES APPROX 140 FT SOUTH OF CALAPOOYA CREEK.

Comp. Declin. 18 1/2° E
Agency DCSO
Party Chief RANDALL W SMITH
Notekeeper Randall W Smith
Witnesses STEPHEN J. FLAUSE

Address

Surveyor's Seal
REGISTERED
PROFESSIONAL
LAND SURVEYOR

Larry E. Monrean

OREGON
JULY 13, 1979
LARRY E. MONREAN
#1830