

GOVERNMENT CORNER RESTORATION FORM

Township R1S Range 9W Sec. 12 County DOUGLAS

State OR Date 4/16/87 No. _____

Corner Designation

1/4
S12
ONLY

- Condition Report Only
- Not Found
- Renewed
- Unrecorded
- Surveyed In
- Referenced Out

Previous Renewals 1967 D. RESURVEY, L.D. ROBERT 1985 CONDITION REPORT

Monument(s) Found: (Condition and Source)

A BLM 3 1/2" DIA BC ON A 2 1/2" I.P.
PROTRUDING 2 IN ABOVE GROUND.
MARKED AS AT RIGHT.

U.S. DEPT. OF THE INTERIOR

1/4
T21S
S12
R9W
1967

BUR. OF LAND MANAGEMENT

Accessories Found:

4" NOW 10" DIA. D. FIR WITH A FULLY HEALED DOUBLE BLAZE
BEARS N12°W, 76.0 FT (AGREES WITH L.D. ROBERTS RLS #1039 CONDITION REPORT,
1967 D. RESURVEY N13°W, 77.2 FT). PER 1967 D. RESURVEY.

5" NOW 18" DIA. D. FIR WITH A FULLY HEALED DOUBLE BLAZE
BEARS S3°W, 72.6 FT (AGREES WELL WITH REC) PER 1967 D. RESURVEY.

1945 GLO BLM I.P. BEARS NORTH 79.7 FT (AGREES WELL WITH L.D. ROBERTS
RLS #1039 1985 CONDITION REPORT) 1967 D. RESURVEY SHOWS A DISTANCE
OF 80.52 FT. W 1/4 S7 T21 S R8 W

WITNESS POST AND SIGN SET BY L.D. ROBERTS RLS #1039 IN 1985
BEARS EAST 1 1/2 FT

#49 T. 21-9 X
#39- T21 8 X

RENEWAL

Monument Set (Procedure and Description)

NONE

Monument Detail

N/A

New Accessories


16" DIA. D. FIR DOUBLE BLAZED "SCRIBED" 1/4 S 12 CS BT"
BEARS N 88 1/2° W, 39.9 FT.

4" DIA. CHERRY TREE DOUBLE BLAZED SCRIBED "X BT"
BEARS S 3° W, 39.0 FT.

Sketch of Monument, Accessories, and General Area

10" D. FIR
N 12° W 76.0 FT

1/4 COR SEC 7 ONLY
NORTH 79.7 FT.

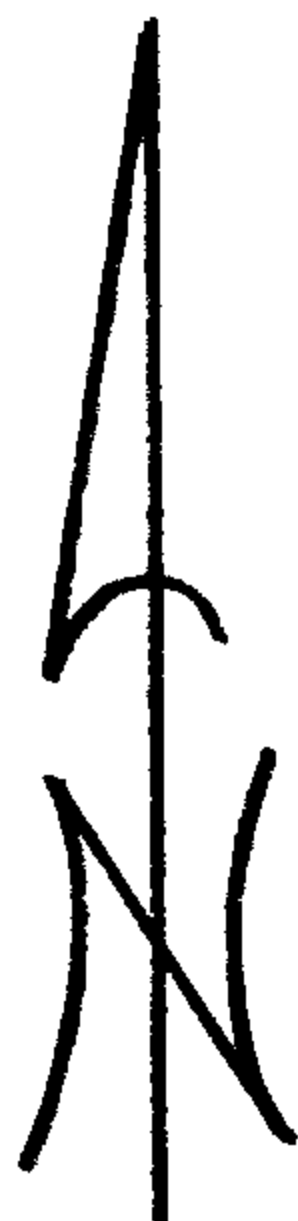

WITNESS POST
SIGN EAST 1 1/2 FT.

16" D. FIR
N 88 1/2° W 39.9 FT

4" CHERRY
S 3° W 39.0 FT.

18" D. FIR
S 3° W 72.6 FT.

- ▲ 1967 BLM B4/1.P.
- △ 1945 GLO B4/1.P.
- 1967 D. RESURVEY BT'S
- NEW BT'S

Location & Comments

CORNER LIES APPROX. 100 FT
SOUTH OF AN EAST - WEST
RIDGE ON A STEEP SOUTHEAST
SLOPE.

Comp. Declin. 18 1/2° E
Agency DCSO
Party Chief RANDALL W. SMITH
Notekeeper Randall W. Smith
Witnesses STEPHEN J. FLAUSE

Address

Surveyor's Seal

REGISTERED
PROFESSIONAL
LAND SURVEYOR

Larry E. Monrean

OREGON
JULY 13, 1979
LARRY E. MONREAN
#1830