

GOVERNMENT CORNER RESTORATION FORM

Township 23S Range 5W Sec. 4 County DOUGLAS

State OR Date 4/21/87 No. _____

Corner Designation

SW COR.
DLC 40

- Condition Report Only
- Not Found
- Renewed
- Unrecorded
- Surveyed In
- Referenced Out

Previous Renewals M34-46 #106, #108, M102-5

Monument(s) Found: (Condition and Source)

A LARGE STONE WITH TOP MEASUREING
 12" X 14" WE DID NOT DIG UP STONE
 TO TAKE DEPTH MEASUREMENT. NO
 DISTINGUISHABLE MARKS FOUND (ORIG.)
 A 5/8" I.R. SET BY W. HAINES (M34-46)
 PROTRUDES 6" ABOVE GROUND ALONG
 NORTH EDGE OF STONE BEARS NORTH
 0.7 FT FROM CENTER OF STONE. (REC.
 NORTH 0.5 FT PER M102-5).

N/A

MONUMENT DETAIL

Accessories Found:

NO ORIG. BT'S FOUND

32" NOW 29" DIA. 3 FT HIGH D.FIR STUMP WITH VISIBLE SCRIBING IN
 A PARTIALLY HEALED DOUBLE BLAZE "SWC. DLC 40 BT" BEARS N74°E,
 11.4 FT (AGREES WITH REC.) BEARING AND DIST. TAKEN FROM CENTER OF
 ORIGINAL STONE. (BT PER REN #106).

26" NOW A SHATTERED STUMP OF INDETERMINABLE SIZE, NO SCRIBING
 OR BLAZES FOUND, BEARS N42°W, 14.7 FT (AGREES WITH REC) BEARINGS
 AND DIST. TAKEN FROM CENTER OF ORIGINAL STONE. (BT PER REN #106).

14" NOW 16" DIA. MADRONE WITH SHALLOW BARK SCRIBING "SWC. DLC 40 CS BT"
 BEARS N34°E, 46.2 FT (REC. N34°W, 46.1 FT BEARING RECORDED IN
 WRONG QUADRANT AND DIST. IS TO 5/8" I.R.) BEARING AND DISTANCES
 TAKEN FROM CENTER OF ORIGINAL STONE (BT PER REN #106).

RENEWAL

Monument Set (Procedure and Description)

Monument Detail

NONE

N/A


New Accessories

26" DIA. 9FT HIGH D. FIR STUMP WITH A BOAT SPIKE THROUGH A BT TAG SET ON TOP. BOAT SPIKE STAMPED "BO 1" BEARS WEST, 11.1 FT BEARING AND DISTANCE TAKEN FROM CENTER OF ORIGINAL STONE.

Sketch of Monument, Accessories, and General Area

Location & Comments

CORNER LIES AT SOUTH WEST CORNER OF YONCALLA CEMETERY. AT THE INTERSECTION OF A EAST-WEST AND NORTH FENCE LINES.

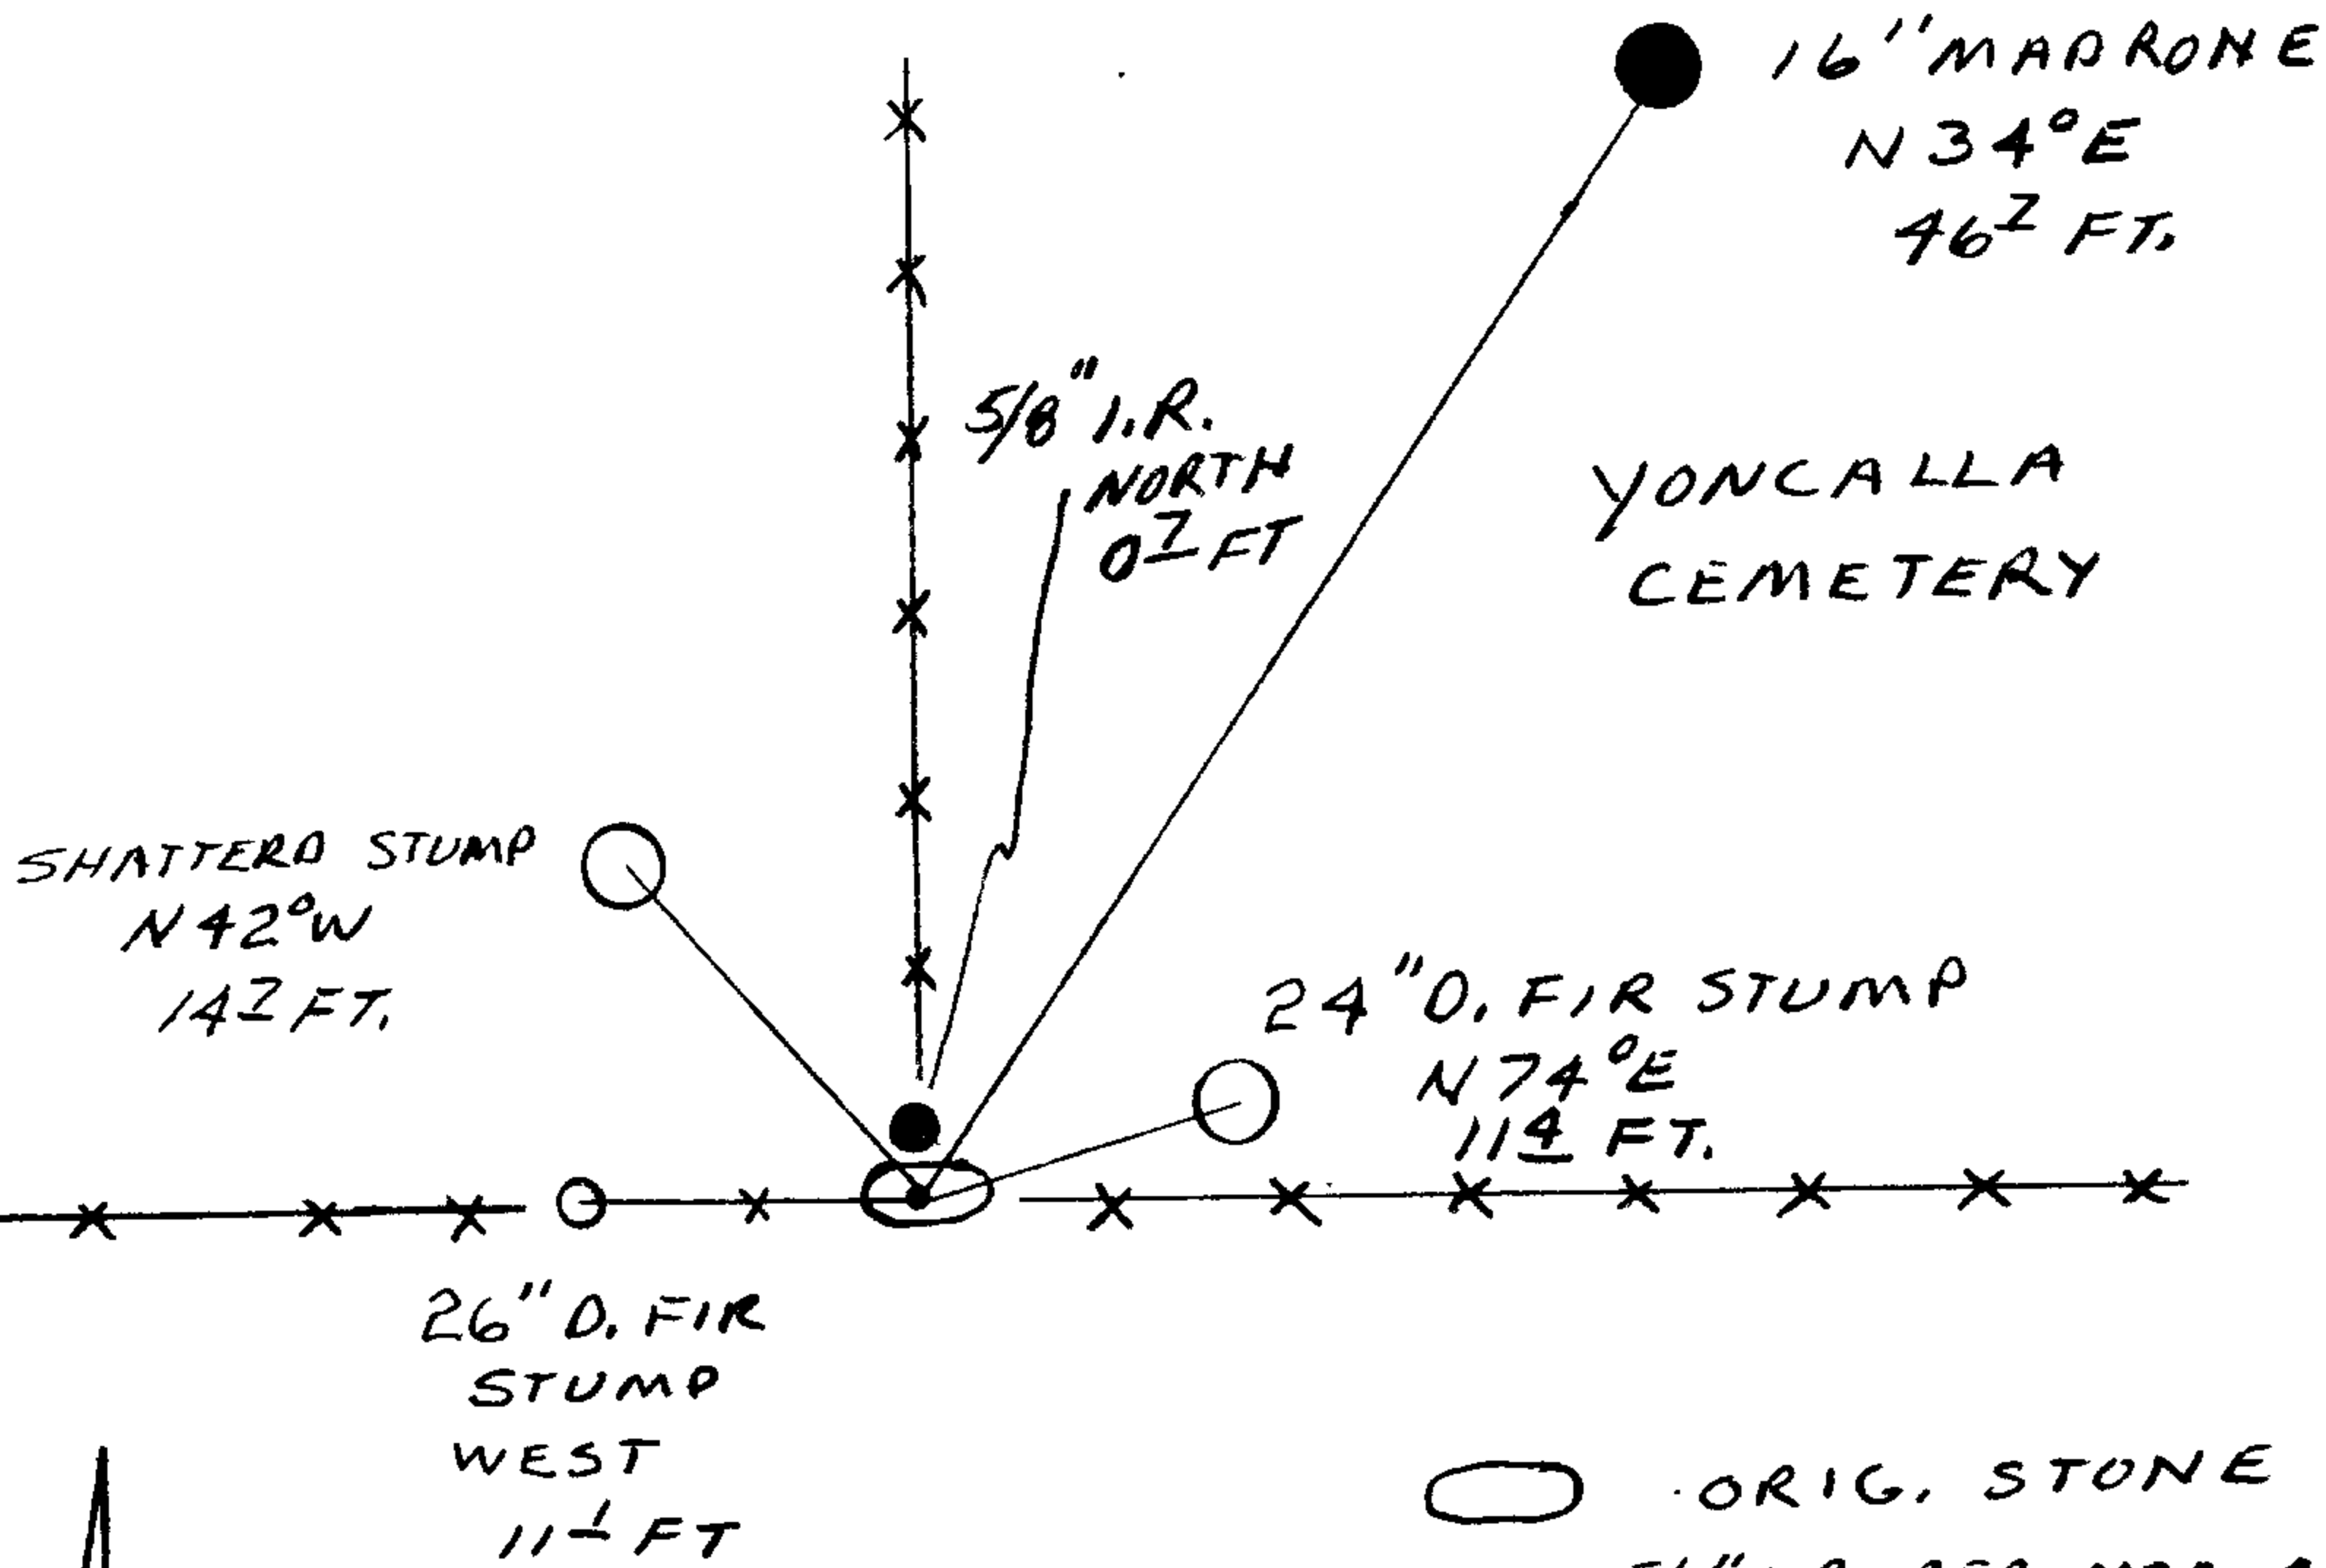

Comp. Declin. 18 1/2° E
Agency DCSO
Party Chief RANDALL W SMITH
Notekeeper Randall W Smith
Witnesses STEPHEN J FLAUSE

Address



OPEN FIELD

- ORIG. STONE
- 5/8" I.R. PER M39-46
- BT'S PER REN. #106
- BT PER REN #108
- NEW BO

Surveyor's Seal

REGISTERED
PROFESSIONAL
LAND SURVEYOR

Larry E. Monrean

OREGON
JULY 13, 1979
LARRY E. MONREAN
#1830