

RENEWAL

Monument Set (Procedure and Description)

Monument Detail

SET 1" (1 3/8" O.D.) X 32" PIPE WITH 2 3/8" BRASS CAP ATTACHED AND STAMPED AS SHOWN ON RIGHT.

DOUGLAS COUNTY SURVEYORS OFFICE

FIRMLY SET AND PROTRUDING APPROXIMATELY 1 FOOT ABOVE GROUND. A 1 1/2 FOOT DIAMETER MOUND OF SAND STONE SURROUNDS PROTRUDING PORTION OF MONUMENT.

T 225

CS
V16

R12W

1986


SEE M101-18 AND C.S 62/43 FOR SURVEY ESTABLISHING CORNER

New Accessories


- A 12 INCH D.B.H. HEMLOCK (PISTOL BUTT), SCRIBED 1/16 S17 CS BT" ON A DOUBLE BLAZE, BEARS N 14 1/2° E, 7.0 FEET.
- A 12 INCH D.B.H. ALDER BARK SCRIBED 1/16 S17 CS BT", BEARS S 37° E, 18 1/2 FEET.
- AN 11 INCH D.B.H. SPRUCE (PISTOL BUTT), SCRIBED 1/16 S17 CS BT" ON A DOUBLE BLAZE, BEARS N 79° W, 31 1/2 FEET.
- A 10 INCH D.B.H. SPRUCE SCRIBED 1/16 S17 CS BT" ON A DOUBLE BLAZE, BEARS N 53° W, 13 1/2 FEET.

Sketch of Monument, Accessories, and General Area

Location & Comments

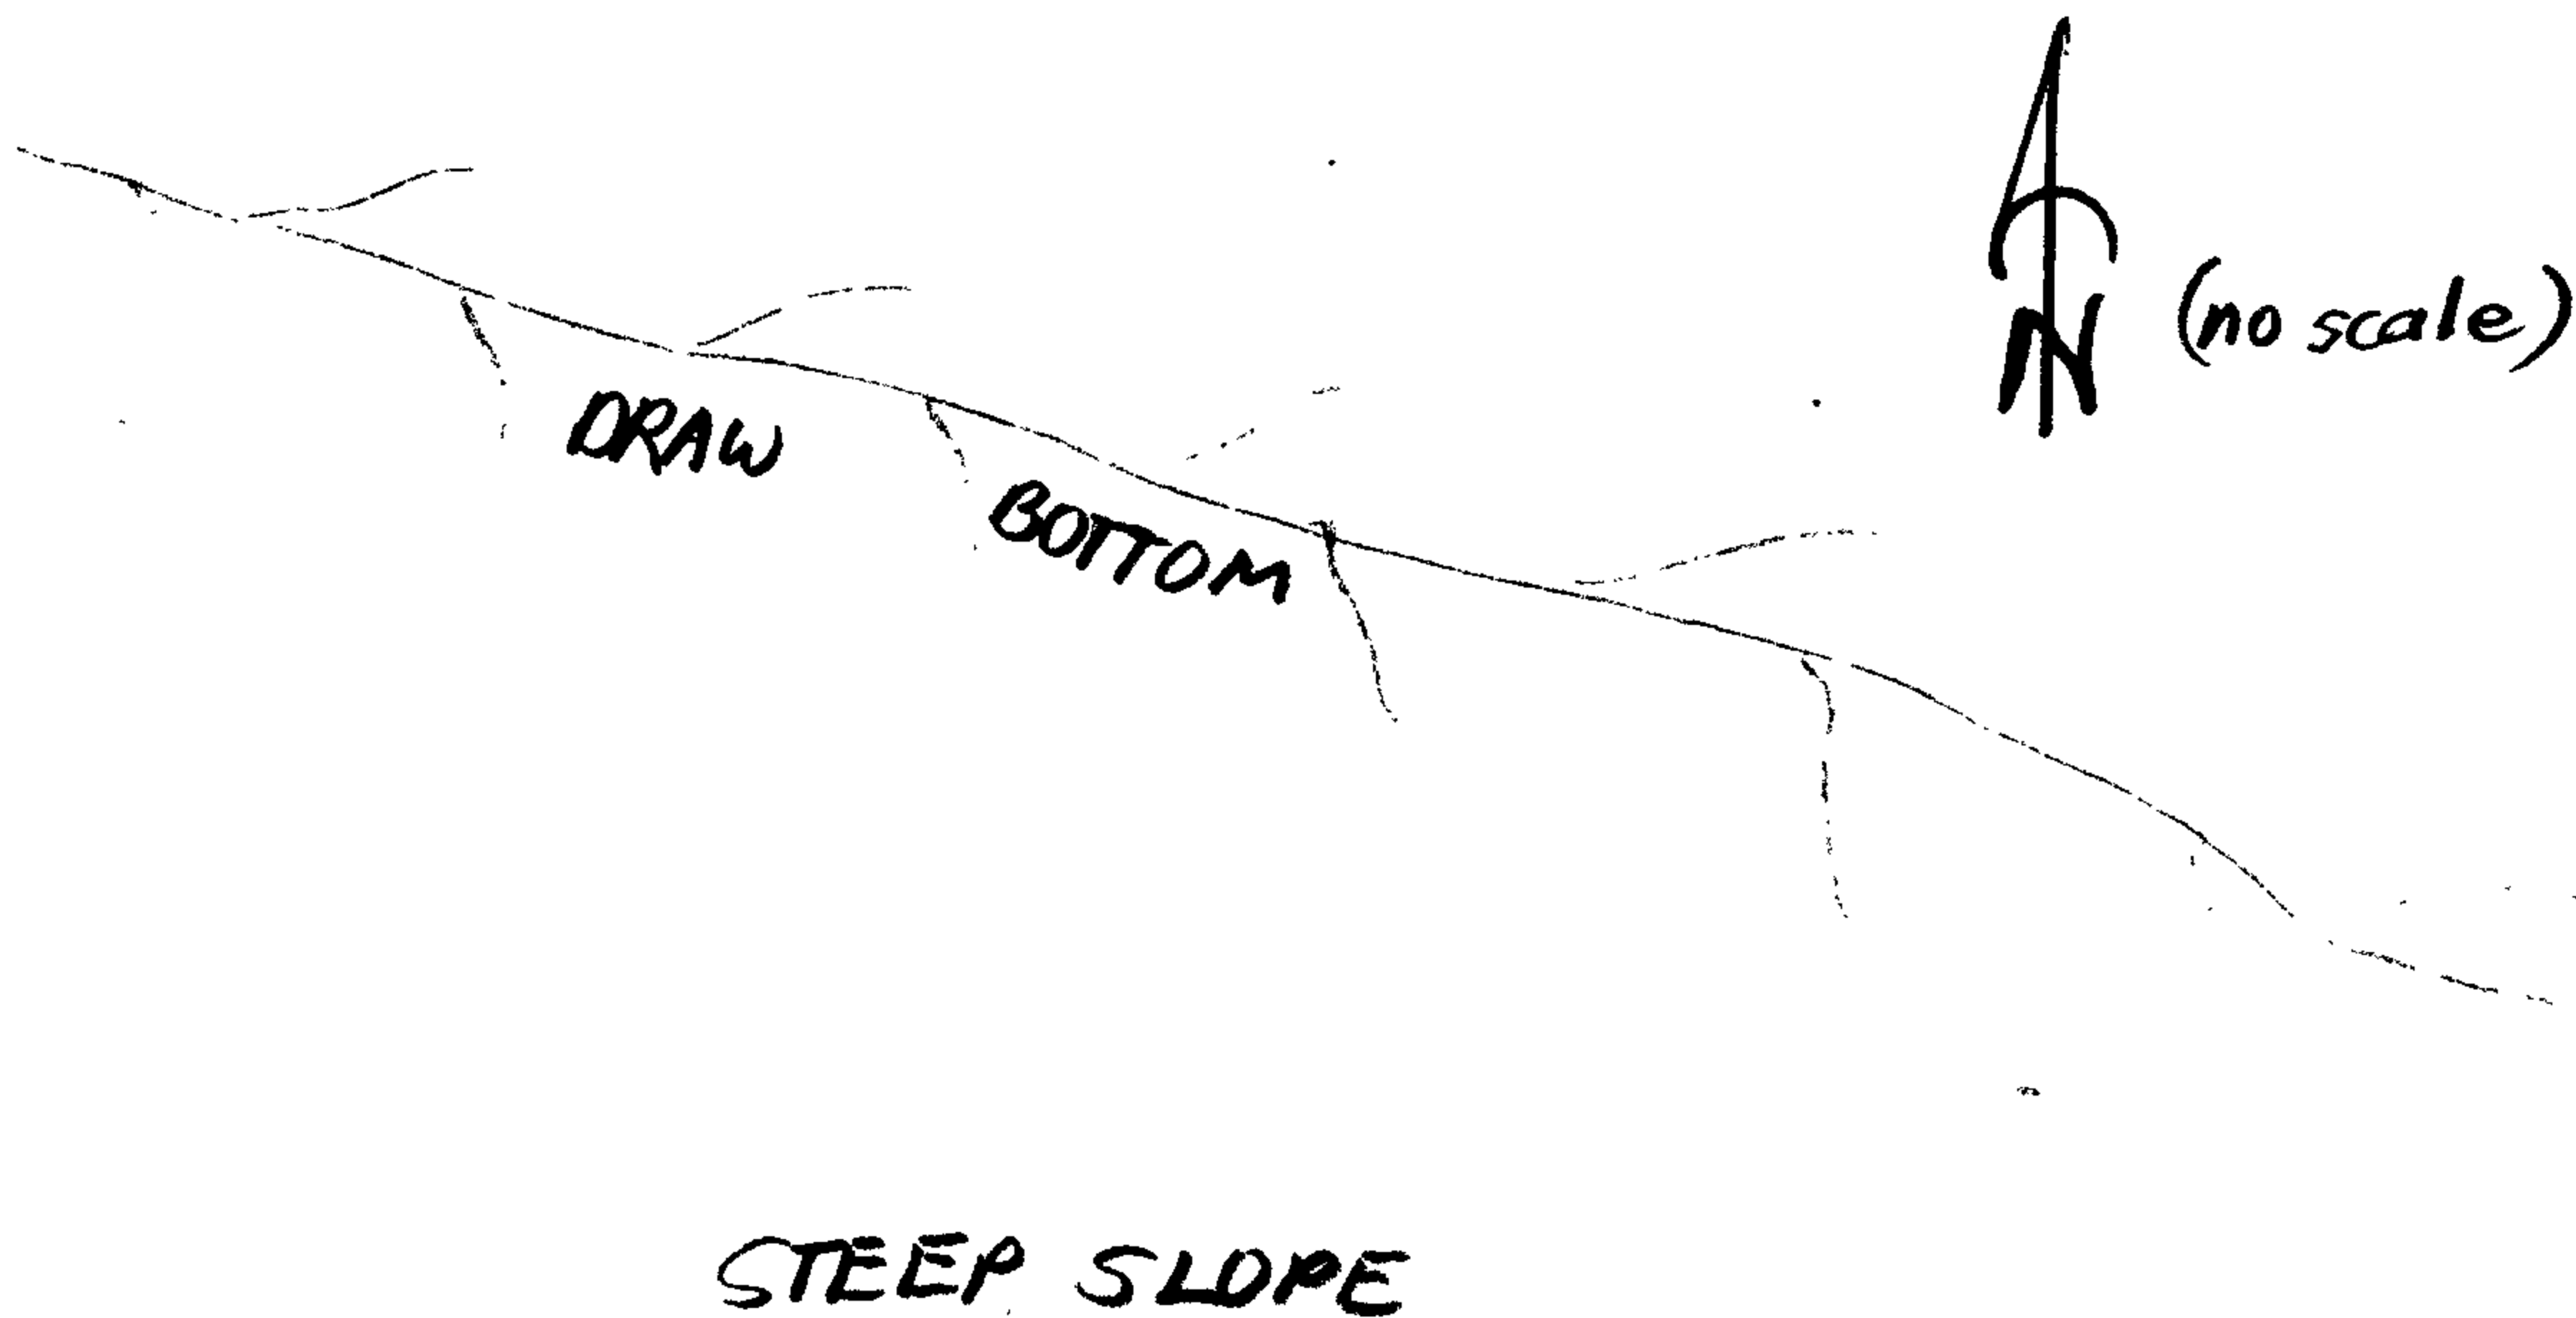

ON STEEP NORTHEAST SLOPE APPROXIMATELY 75' ABOVE A DRAW BOTTOM RUNNING NORTH WEST.

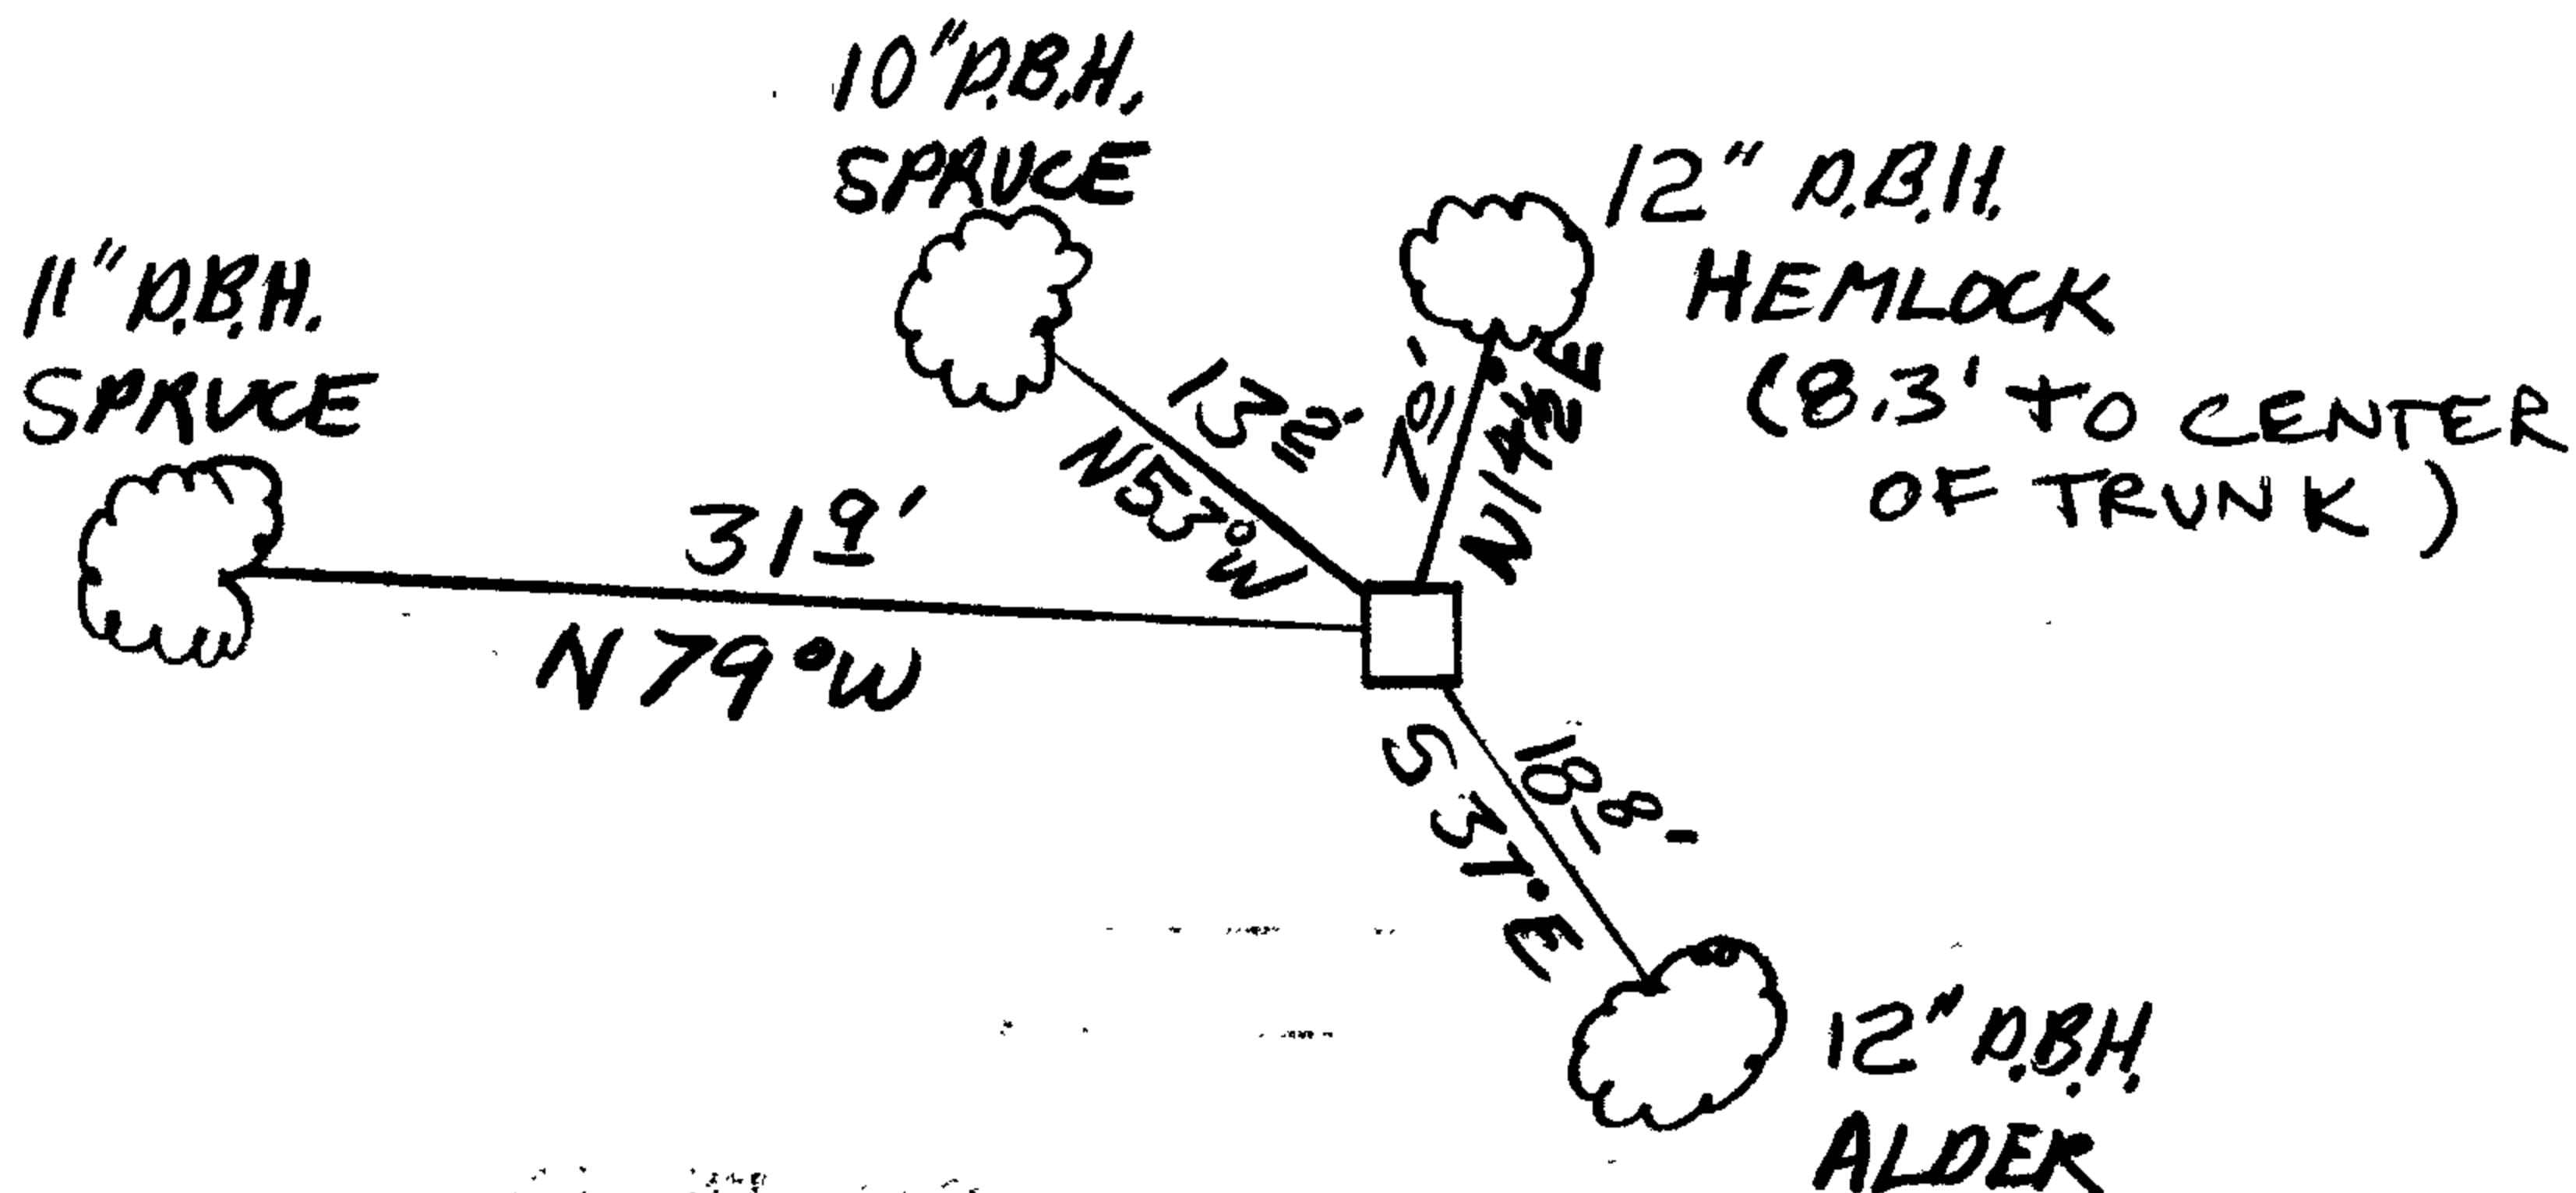

Comp. Declin. 18 1/2° E

Agency DCSD

Party Chief J R LUNDEEN

Notekeeper JRL

Witnesses RANDY W SMITH

Stephen John House

Address ROOM 205 JUSTICE HALL
Roseburg, OR 97470

REGISTERED'S Seal
PROFESSIONAL
LAND SURVEYOR

Janet R. Lundeen

OREGON
FEBRUARY 4, 1983
JANET R. LUNDEEN
2032