


CERTIFIED RECORD OF LAND CORNER MONUMENTATION

History of original corner establishment: Corner established by George Grubb, L.S. 397, in 1981 on M87-65:

set 2"x30" iron pipe, 36" in the ground with a 2 1/2" brass cap marked:

T26S R1W  
NE 1/16 S10  
1981  
LS 397

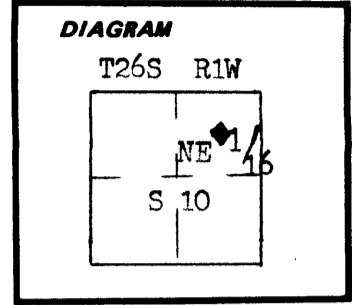


from which:

- a 2"x2" "x" chisled in a 2"x4"x10" stone set in concrete at the top NE corner of "Umpqua National Forest Picnicground Bogus Creek" signpost foundation bears S71°26'02"W, 112.46 ft.
- a 2"x2" "x" chisled in a 4"x8"x8" stone set in concrete at the top SW corner of "Umpqua National Forest Campground Bogus Creek" sign post foundation bears S75°02'08"E, 177.19 ft.

Description of corner evidence found: February 10, 1988, I found a 2 1/2" brass cap buried 6" under the ground and marked as shown:  
from which:

- a 2"x2" "x" at the top S W corner of the campground sign post foundation bears S75°E, 177.2 ft.
- a 2"x2" "x" at the top NE corner of the picnicground sign post foundation bears S71 1/2°W, 112.5 ft.

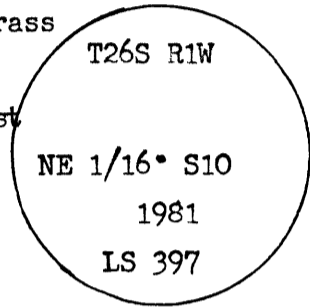

Description of monument and accessories | established to perpetuate the

original location of this corner: February 10, 1988, due to impending removal of the campground and picnicground signs, I establish 2 new bearing trees:

- a 10" Douglas Fir, N54°W, 23.7 ft., scribed "NE 1/16 BT" on a single blaze.
  - an 8" White Fir, N0 1/2°W, 26.5 ft., scribed "S10 BT" on a single blaze.
- Both new bearing trees have a 3/4" diameter brass washer, stamped "LS 1181", nailed flush to the lower portion of the blaze.

The corner is 2.0 ft. North of the north edge of the pavement of Highway 138.

The bearing trees were not tagged and the blazes painted black due to the proximity of the campground.

I found the magnetic declination to be 18 1/4° East.

Party chief: Leonard Herzstein  
Witness: Peggy Roberts

REGISTERED  
PROFESSIONAL  
LAND SURVEYOR

*Maurice E. Farr*

OREGON  
SEPT. 23, 1977  
MAURICE E. FARR  
1181

2-12-87

Office of.....Surveyor..... County of....Douglas.....  
 State of..Oregon....., I hereby certify that the within instrument was filed in this office  
 for record on the....17. day of...February....., 19...88  
 ..Fritz Ingram..... by *Virginia A. Sargent*.....  
 (COUNTY OFFICIAL) (DEPUTY)

Form R6-7100-57 (9/71)

FILED *ff*  
 FEB 17 1988  
 COUNTY SURVEYOR  
 DOUGLAS COUNTY, ORE.

C.S. File No. 62/44-2