

GOVERNMENT CORNER RESTORATION FORM

Township 27S Range 3W Sec. 21 County DOUGLAS

State OR Date 9/16/87 No. _____

Corner Designation

S21 | S22
S28 | S27

Condition Report Only
Not Found
 Renewed
Unrecorded
Surveyed In
Referenced Out

Previous Renewals #48, BLM RESURVEY'S 1959 AND 1979

MONUMENT DETAIL

Monument(s) Found: (Condition and Source)

A DC SO 1 1/2" O.D. I.P. THAT'S 36" LONG WITH A 2 1/2" BRASS CAP, BENT AND OUT OF GROUND. PER REN #48 1958 BLM E.C./I.P. NOT FOUND

COUNTY SURVEYOR'S OFFICE

T27S

S21 | S22
S28 | S27

R3W

1957

Accessories Found:

ORIGINAL BT'S

20" NOW 36" DIA. P. FIR WITH EVIDENCE OF BARK BLAZE AND AXE MARKS NO SCRIBING FOUND, BEARS N10°W, 24.4 FT (AGREES WITH REC.)
15" LAUREL NOW 34" DIA. MADRONE WHICH WAS PREVIOUSLY OPENED, WE OPEN FURTHER, NO BLAZE OR SCRIBING FOUND. BEARS S54°E, 75.9 FT (BT NOTED AS A DEPRESSION IN REN #48; S54°E, 74.6 FT PER 1957 BLM RESURVEY; S54°E, 75.9 PER 1979 BLM RESURVEY; ORIGINAL 74.6 FT IS A POSSIBLE FACE MEASUREMENT).

NO OTHER ORIGINAL BT'S FOUND

BT'S PER REN #48

10" NOW 14" DIA. CEDAR WITH A FULLY HEALED DOUBLE BLAZE BEARS S15°E, 48.8 FT (S15°E, 59.2 FT PER REN #48, S15°E; 59.1 PER 1958 BLM RESURVEY; S15°E, 48.8 FT PER 1979 BLM RESURVEY).

14" NOW 27" DIA. SUGAR PINE WITH A FULLY HEALED DOUBLE BLAZE N26°W, 14.2 FT (AGREES WITH REC.)

12" NOW 16" DIA. CEDAR WITH A PARTIALLY HEALED DOUBLE BLAZE ILLEGIBLE SCRIBING VISIBLE, BEARS N68 1/2°E, 60.2 FT (N70°E, 60.2 FT PER REN #48; N68 1/2°E, 60.2 FT PER 1958 AND 1979 BLM RESURVEY).

36" FIR BEARING S75°W, 5.0 FT GONE BY RECENT CAT WORK
BT'S PER 1958 BLM RESURVEY

10" NOW 12" DIA. CHINQUAPIN WITH A FULLY HEALED SINGLE BLAZE, BEARS N40°E, 71.3 (AGREES WITH RECORD).

8" NOW 11" DIA. CHINQUAPIN WITH PARTIALLY HEALED SINGLE BLAZE, SCRIBING VISIBLE "S R3W S28 BT" BEARS S52 1/2°W, 23.1 FT (AGREES WITH RECORD).

6" NOW 8" DIA. O. FIR WITH A FULLY HEALED SINGLE BLAZE, BEARS N14 3/4°W, 29.3 FT

#152 ✓

C

RENEWAL

ACCESSORIES FOUND:

Monument Set (Procedure and Description)

(REC. N14 3/4° W, 30.4 FT POSSIBLE SLOPE MEASUREMENT)
 8" NOW 11" DIA. BROKEN 10" HIGH CHINQUAPIN STUMP
 NO BLADES OR SCRIBING FOUND, BEARS S22 1/2° E, 17.2 FT
 (AGREES WITH RECORD) BTA CASUALTY OF RECENT
 CAT WORK, TRUNK PUSHED OVER BANK.

Monument Detail

COUNTY SURVEYOR'S OFFICE

T 275

RESET

S21	S22
S28	S27

 1987
 R3W
 1957


MONUMENT SET (PROCEDURE AND DESCRIPTION)

POSITION OF CORNER REESTABLISHED BY USING
 BEARING TREES OF RECORD. 1957 DCSO BC/11.P.
 STRAIGHTENED AND SET FIRMLY IN GROUND.
 6 IN. OF BC/11.P. PROTRUDES ABOVE GROUND, THE
 STAMPING "RESET 1987" IS ADDED TO BRASS CAP.

New Accessories

NONE

Sketch of Monument, Accessories, and General Area

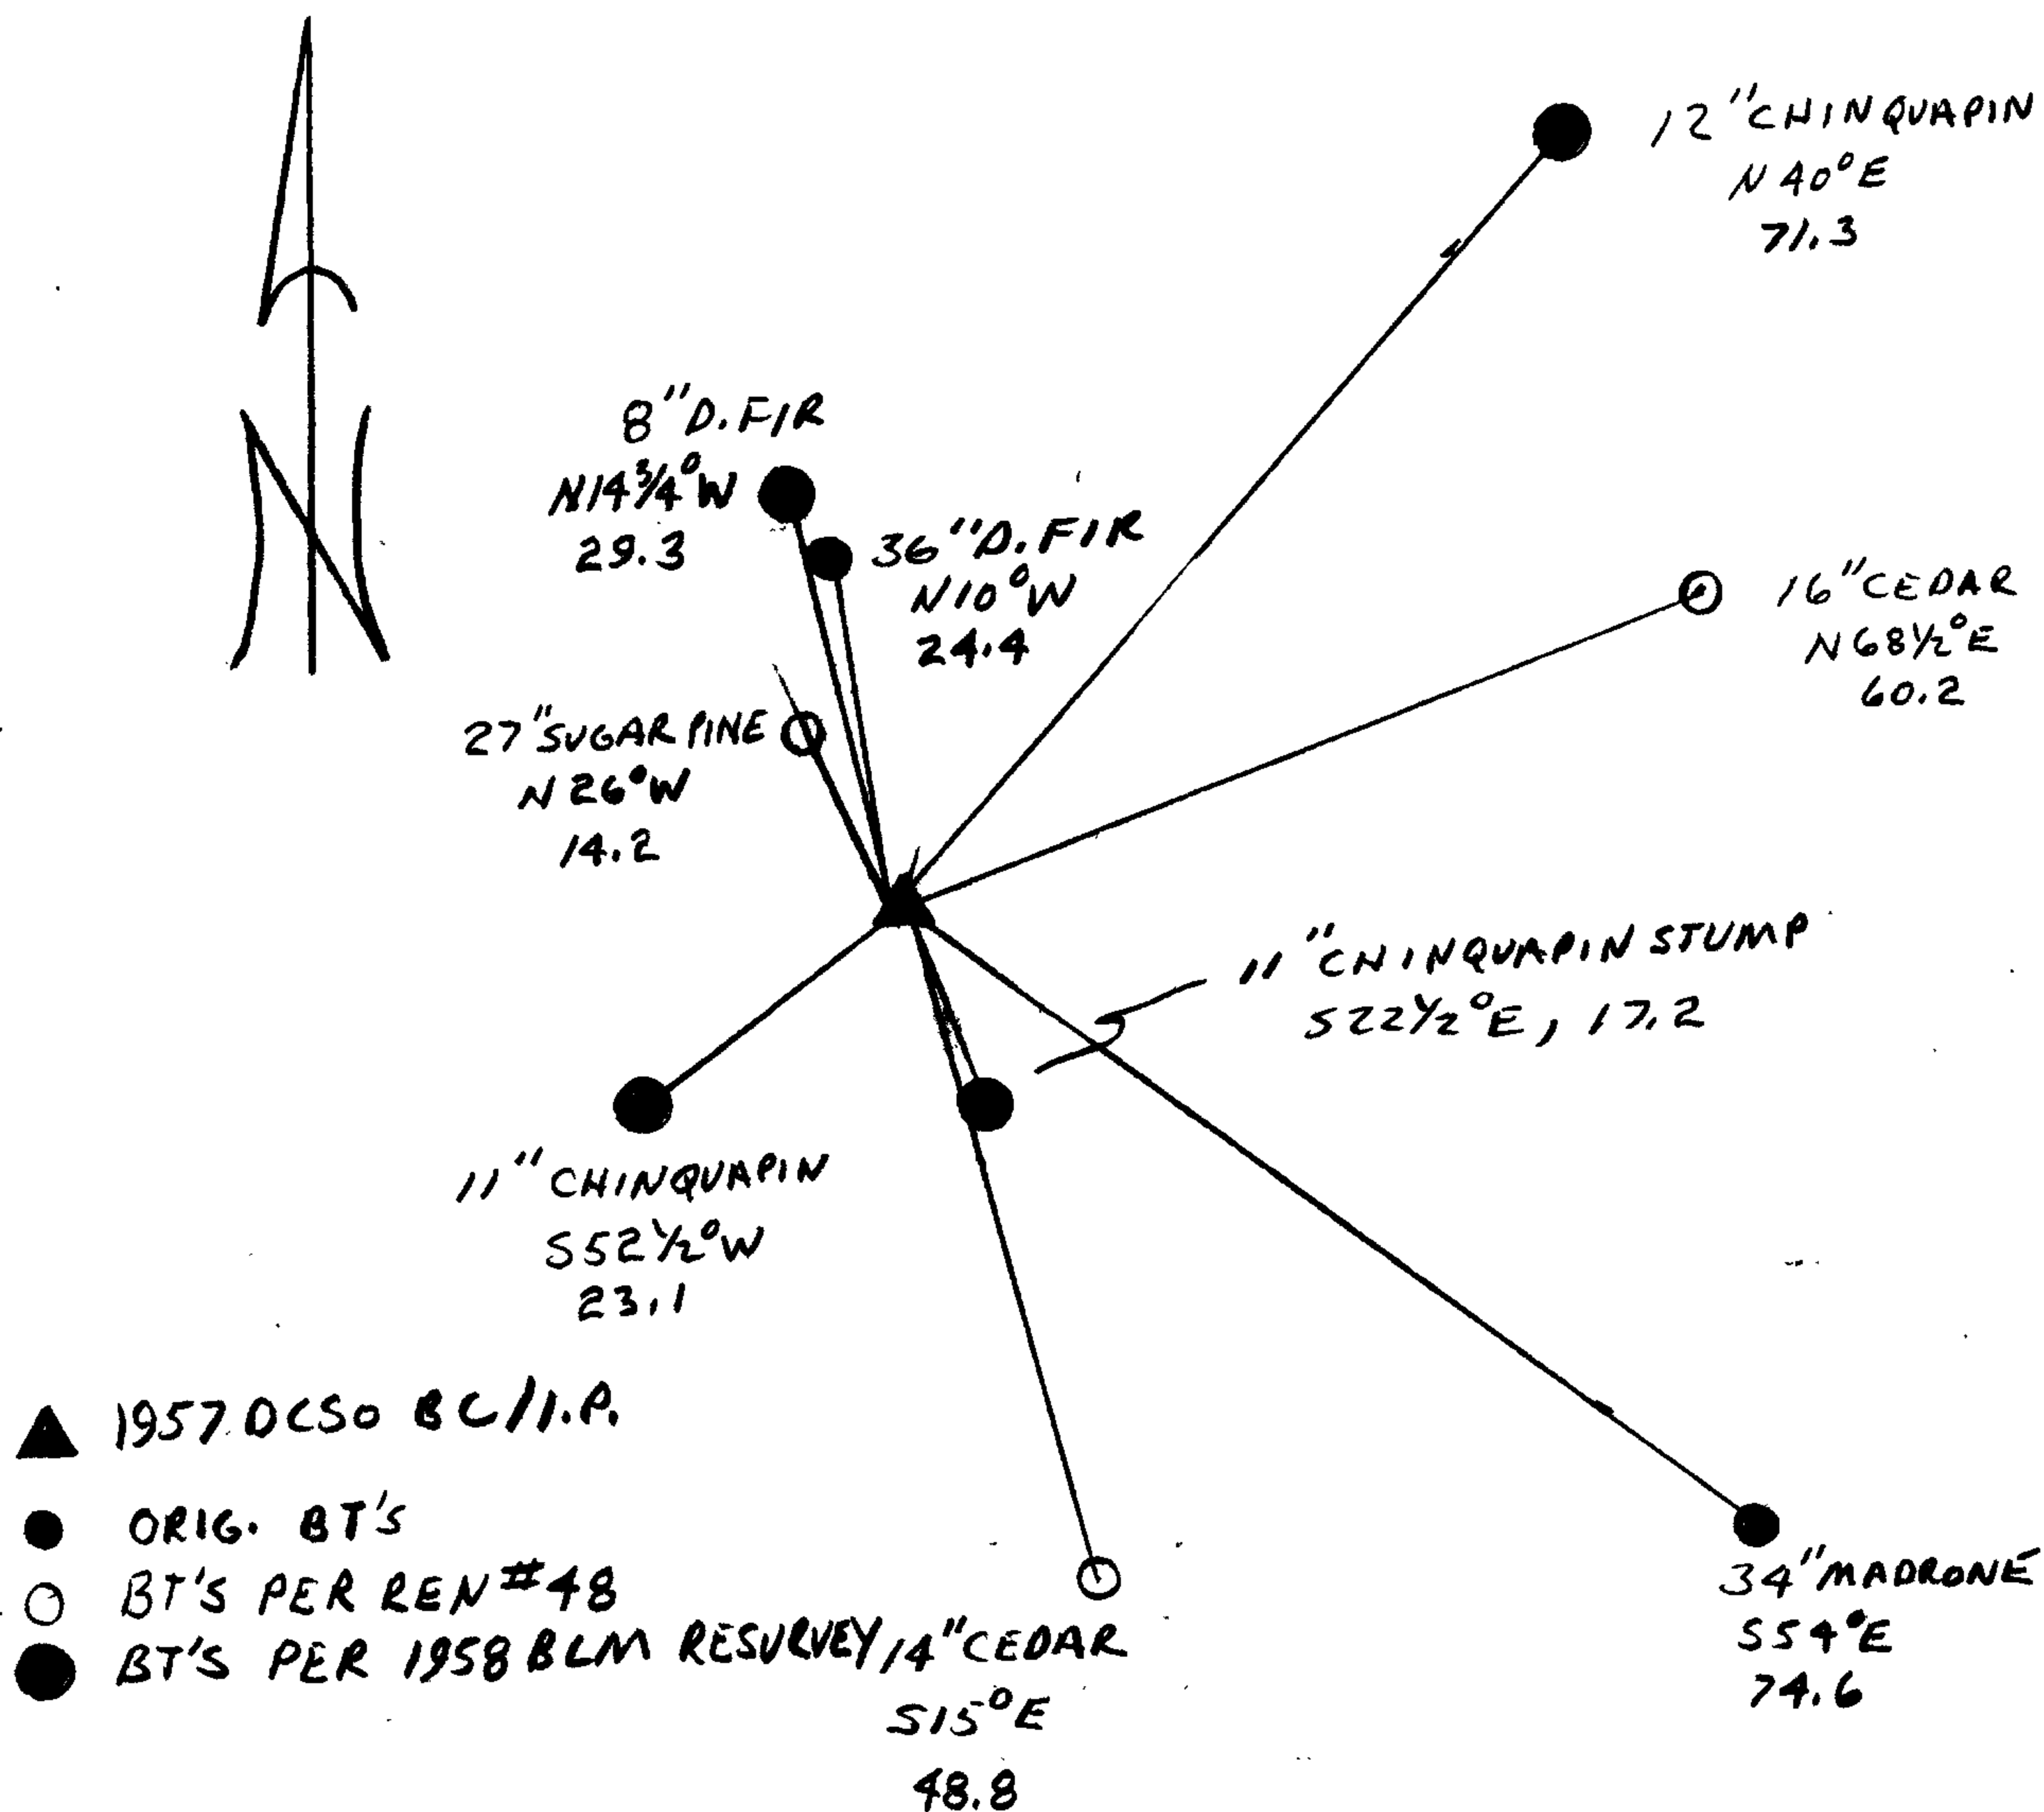

Location & Comments

CORNER LIES NEAR TOP
 OF A NE-SW RUNNING
 RIDGE IN THE MIDDLE OF
 A RECENT CAT ROAD.

Comp. Declin. 18 1/2° E
 Agency DCSO
 Party Chief RANDALL W SMITH
 Notekeeper STEPHEN J ELAUSE
 Witnesses

Address

Surveyor's Seal

REGISTERED
 PROFESSIONAL
 LAND SURVEYOR

Stephen J. Elause

OREGON
 JULY 13, 1979
 LARRY E. MONREAN
 #1830