

GOVERNMENT CORNER RESTORATION FORM

Township 32S Range 5W Sec. 29 County DOUGLAS

State OR Date 5/1/87 No. _____

Corner Designation

1/4 S29
S32

VOL 2, Pg 263

Previous Renewals #107, BLM 1964 D. RESURVEY

Monument(s) Found: (Condition and Source)

ABLIM 3/4" BRASS CAP ON A 2 1/2" O.D. IRON PIPE
PROTRUDES 10 IN. ABOVE GROUND.

A 3/4" I.D. IRON PIPE, FIRMLY SET, PROTRUDES
4 IN. ABOVE GROUND. (I.P. WAS COVERED
BY DUFF) PER REN #107

Accessories Found:

BEARINGS AND DIST. TAKEN ^{FROM} 1962 BLM BC/I.P.

14" NOW 18" DIA. D. FIR WITH A FULLY HEALED SINGLE BLAZE,
BEARS N 57 1/2° E, 17.2 FT (AGREES WITH REC.) PER BLM 1964 D. RESURVEY

8" NOW 10" DIA. MADRONE WITH A FULLY HEALED SINGLE BLAZE
BEARS S 4° E, 29.7 FT (AGREES WITH REC.) PER BLM 1964 D. RESURVEY

3/4" I.D. I.P. SET AS 1/4 COR. PER REN #107 BEARS N 17 1/2° E,
29.0 FT (REC S 17 1/2° W, 29.9 FT; BEARING APPARENTLY REVERSED
IN BLM RECORDS. DIST. IS A PARTIAL SLOPE DIST.)

BEARINGS AND DISTANCES TAKEN TO 3/4" I.D. I.P. PER REN #107

13" NOW 11" DIA. D. FIR WITH A FULLY HEALED DOUBLE BLAZE
BEARS S 29° E, 12.4 FT (AGREES WITH REC.) PER REN #107

18" STILL 18" DIA. MADRONE WITH A PARTIALLY HEALED DOUBLE BLAZE,
WITH PARTIAL SCRIBING AND "BT" VISIBLE, BEARS N 2° W, 46.5 FT
(AGREES WITH REC. PER REN #107).

- Condition Report Only
- Not Found
- Renewed
- Unrecorded
- Surveyed In
- Referenced Out

MONUMENT DETAIL

U.S. DEPT. OF THE INTERIOR

T 32S R 5W

1/4 S29
S32

1962

BUR. OF LAND MANAGEMENT

#222 +

RENEWAL

Monument Set (Procedure and Description)

NONE


Monument Detail

N/A

New Accessories

18" DIA. MADRONE (PER REN #107) SHOWS A DOUBLE BLAZE WITH PARTIAL SCRIBING AND "BT" IN LOWER BLAZE, BEARS N 4° E, 69.7 FT.

Sketch of Monument, Accessories, and General Area

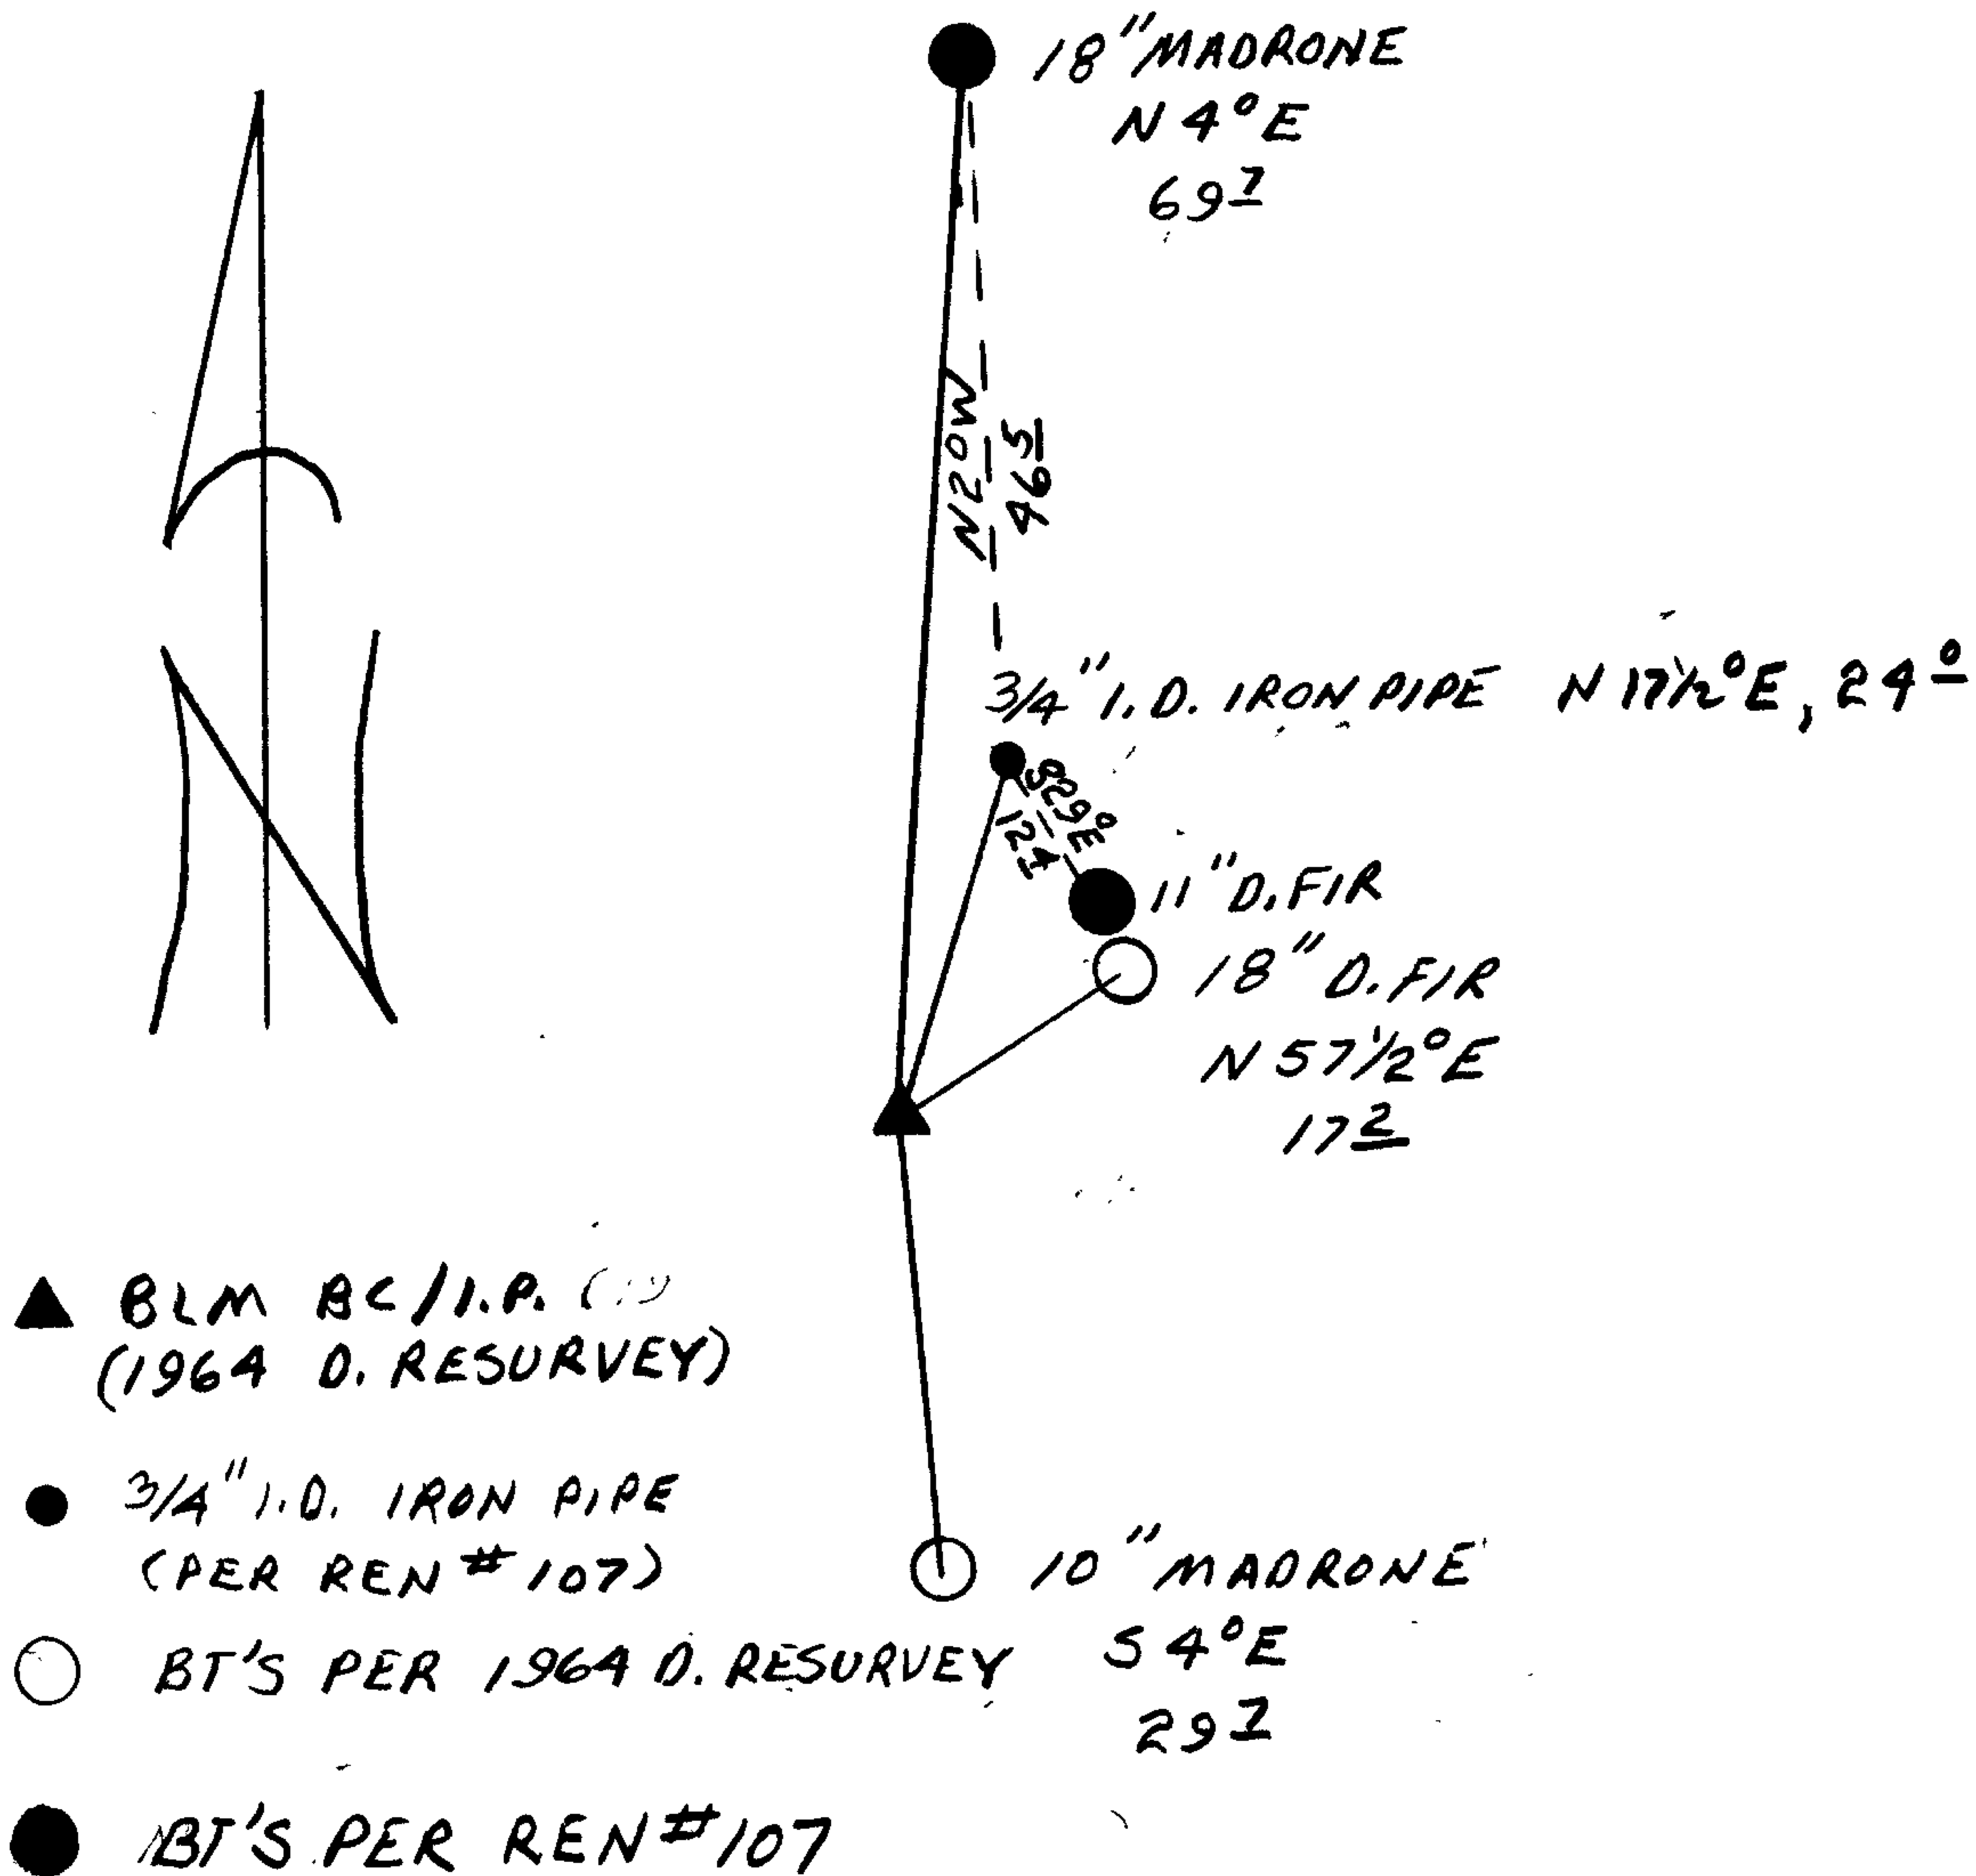

Location & Comments

CORNER LIES ON A SOUTHWESTERLY SLOPE.

SEE ALSO M 101-16

Comp. Declin. 18 1/2° E
Agency DCSO
Party Chief RANDALL W. SMITH
Notekeeper STEPHEN J. ELAUSE
Witnesses

Address

Surveyor's Seal

REGISTERED
PROFESSIONAL
LAND SURVEYOR

Larry E. Monrean
OREGON
JULY 13, 1979
LARRY E. MONREAN
#1830