

RENEWAL

Monument Set (Procedure and Description)

Monument Detail

NONE

N/A


New Accessories

- 9" D. FIR DOUBLE BLAZED AND SCRIBED " 1/4 S24 CS BT "
- BEARS S31°E, 7.0 FT.
- 11" W. FIR DOUBLE BLAZED AND SCRIBED " 1/4 S23 CS BT "
- BEARS N66°W, 32.2 FT.
- 7" D. FIR DOUBLE BLAZED AND SCRIBED " 1/4 S23 CS BT "
- BEARS S56 1/4°W, 18.5 FT.

Sketch of Monument, Accessories, and General Area

Location & Comments

CORNER LIES APPROX. 700 FT WEST OF A DIRT ROAD ON TOP OF AN EAST-WEST BRIDGE.

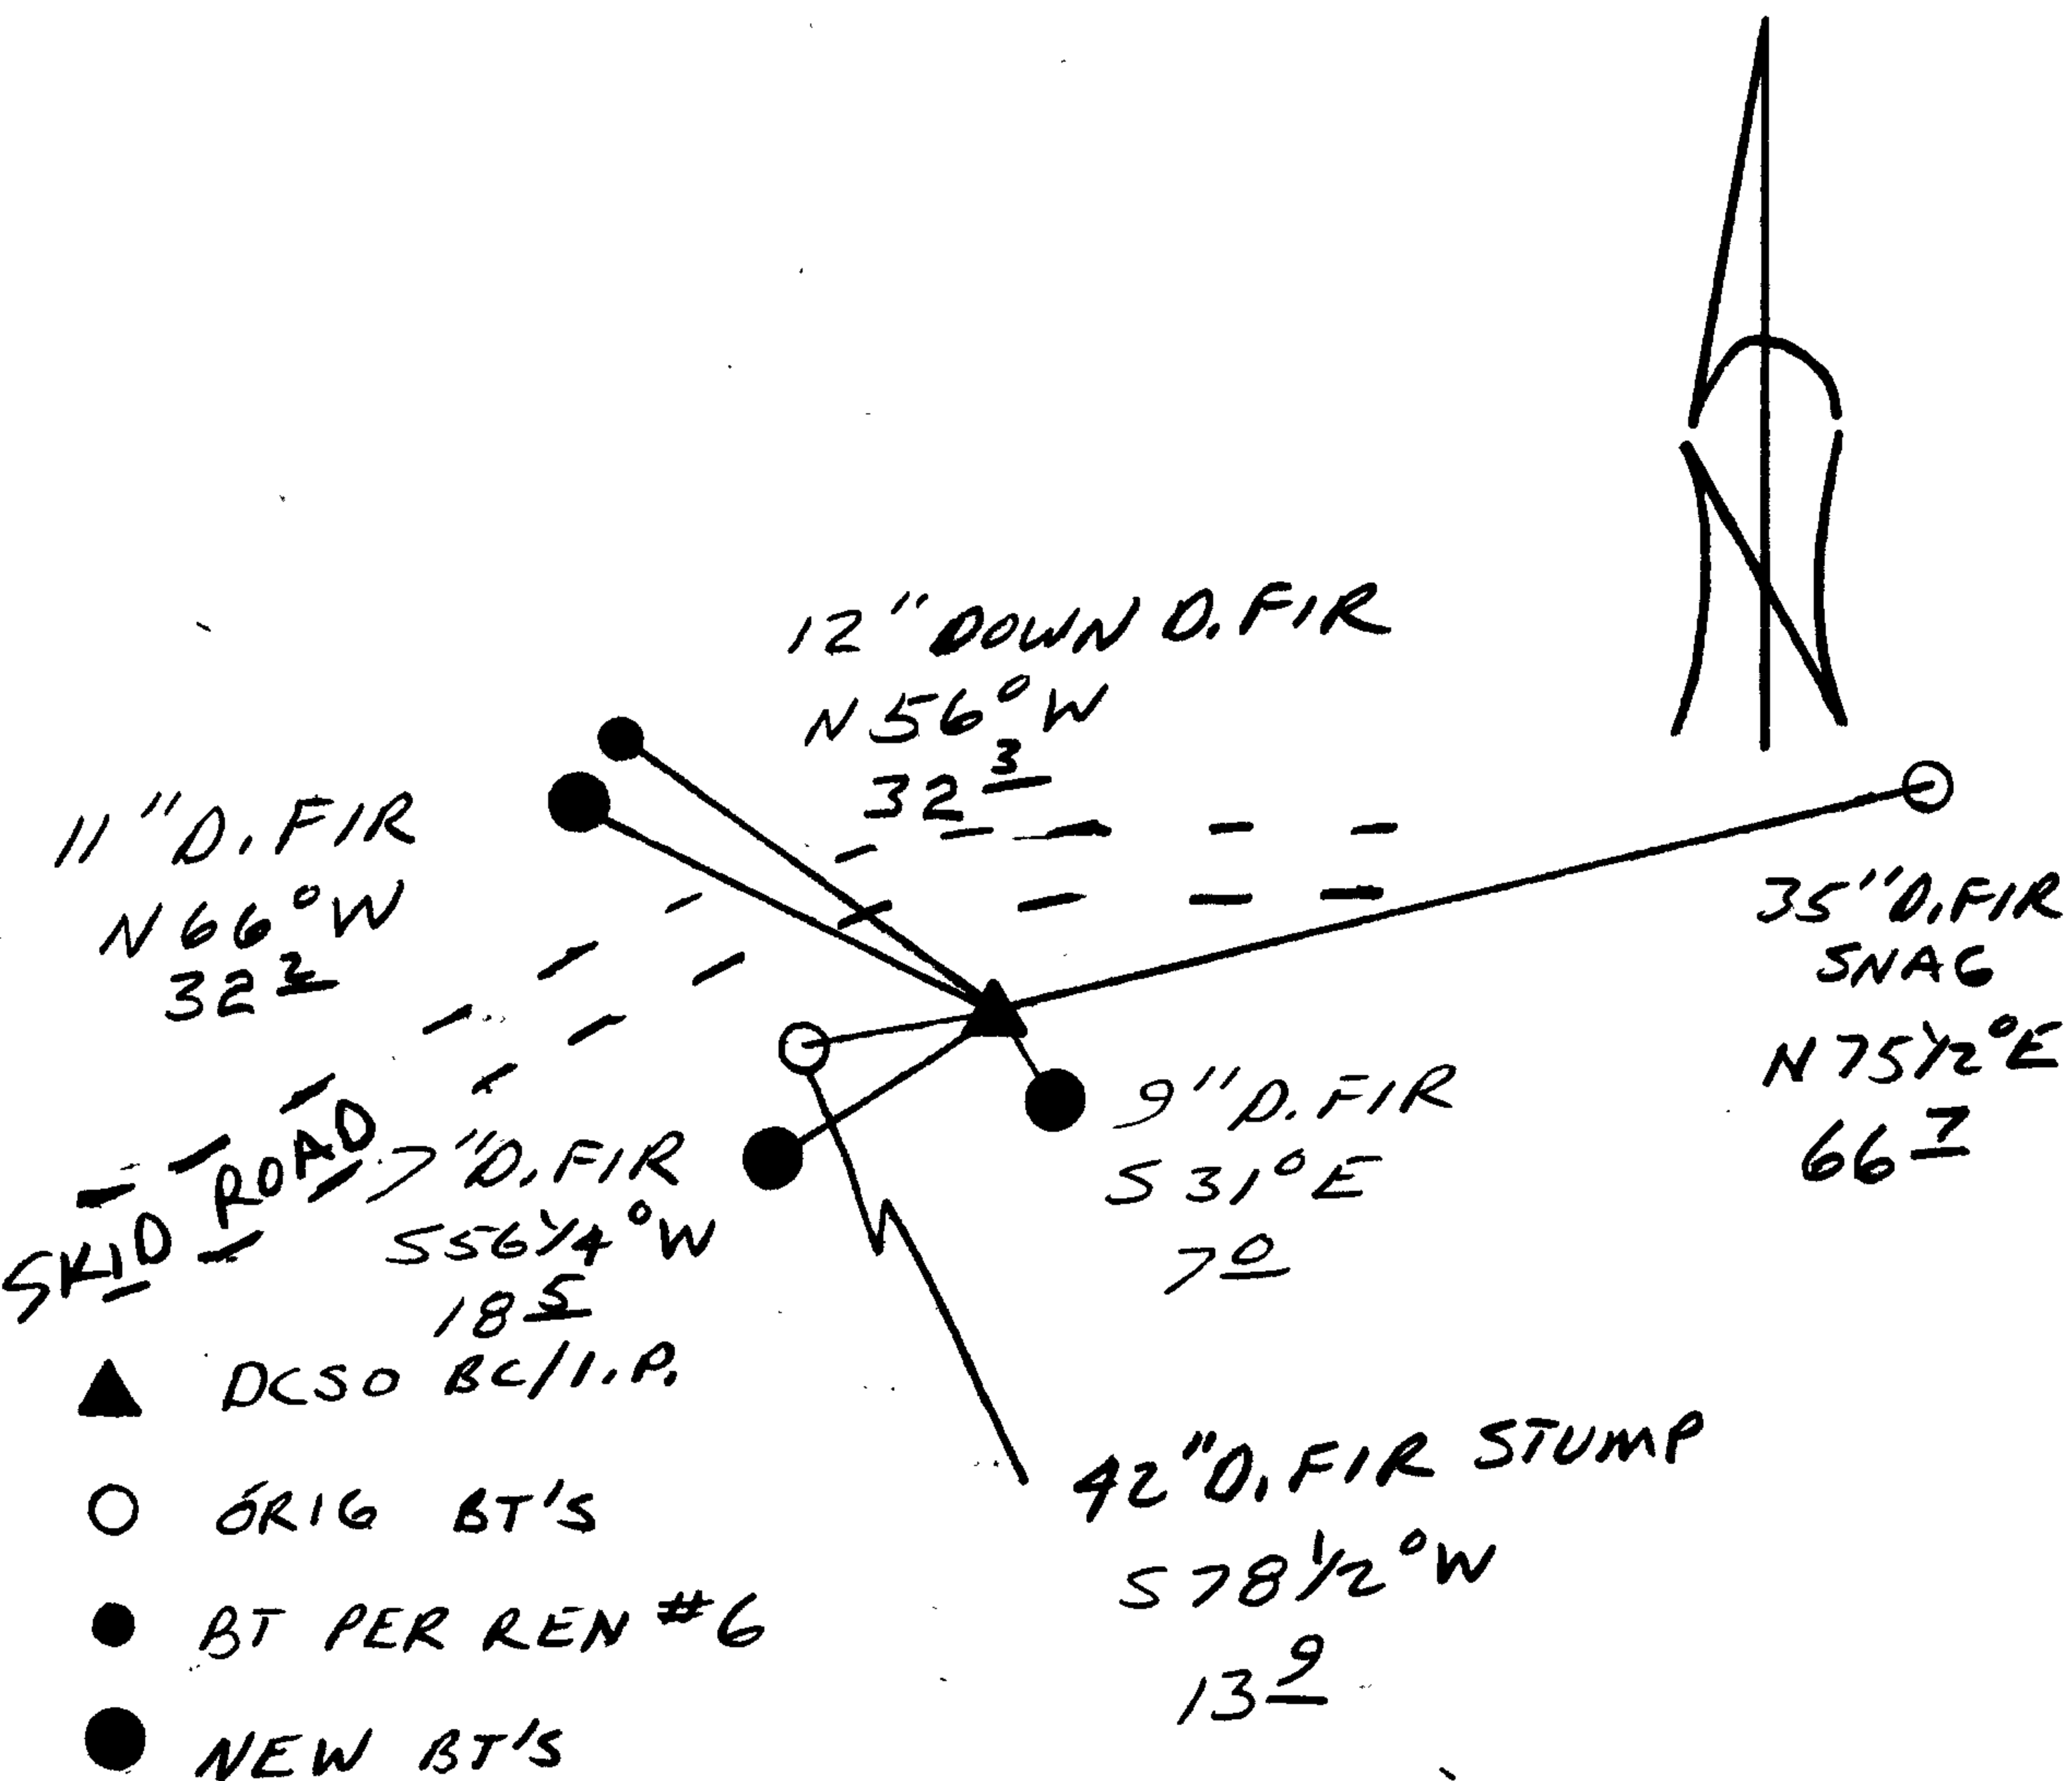

Comp. Declin. 18°E
 Agency DCSO
 Party Chief RANDALL W. SMITH
 Notekeeper STEPHEN J. ELAUSE
 Witnesses

Surveyor's Seal

REGISTERED PROFESSIONAL LAND SURVEYOR

Larry E. Monrean

OREGON
JULY 13, 1979
LARRY E. MONREAN
#1830

FEB 4 1988

OREGON CORNER RESTORATION FORM

COUNTY SURVEYOR
DOUGLAS COUNTY, ORE.

Section 23 Township 24S Range 8W

County Douglas Date 1/27/88

Corner Designation

- Condition Report Only
- Not Found
- Renewed
- Unrecorded
- Surveyed In
- Referenced Out

Previous Renewals/Surveys, etc. _____

Monument(s) & Accessories Found: (Condition and Source)


DSC 9180-11
July 1975

LOCAL RECORD

UNITED STATES
DEPARTMENT OF THE INTERIOR
BUREAU OF LAND MANAGEMENT

CORNERS OF THE CADASTRAL SURVEY GRID

T. 24S R. 8W, WILL Mer., OREGON State.

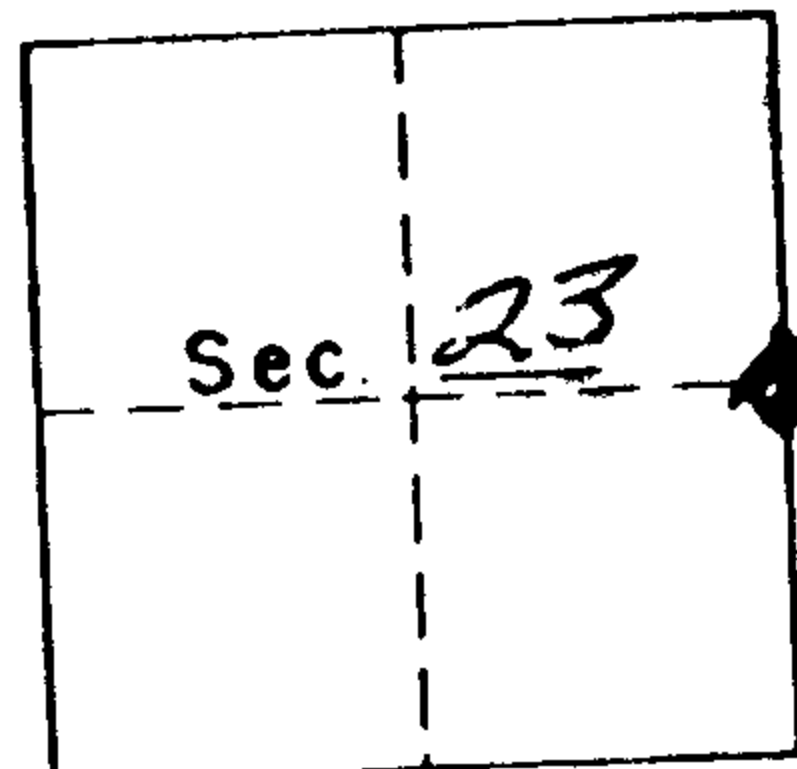

SYMBOLS

- Official corner found
- Probable corner found, authenticity doubtful.
- Corner searched for and not found.

Reported By T. M. KATWYK
 Signature
ASSISTANT A. M.
 Title
1-27-88
 Date

1/4 Corner common to Secs. 23, 24 & _____ is a mound of stone,
 tree, rock, fire pit, iron pipe, COUNTY BRASS CAP size _____

LEGIBLE MARKS ON BEARING OBJECTS

	BT TAG ONLY	1/4 524 CSBT		
KIND	DF	DFSUR		
SIZE	12"	35"		
BEARING	N42W	N75/12E		
DISTANCE	33 FT	66.7 FT		
BT TAG POSTED	yes	yes		

ADDITIONAL INFORMATION

THE 12 INCH BT IN SEC 23 WAS PUSHED OVER AND MOVED FROM ORIGINAL LOCATION WHEN AREA WAS LOGGED. HAS A BT TAG ON IT. TREE IS VERY ROTTEN NOW. THE BT IN SEC 24 IS A 16 FT HIGH SNAG. TREE DIED SHORTLY AFTER RESURVEYING IN 1958. PUT UP NEW (OVER) BT TAG

New Accessories

Location & Comments

Surveyor's Seal

Compass Declination 20°

Firm/Agency BLM

Address 277 NW Garden Valley Blvd

Roseburg OR

Party Chief Tm Katwyk

Notes _____

Witness _____

2 1/2" DCSO BC ON 1 3/8" U.D. 1P
protruding 8" ABOVE GRND.

COUNTY SURVEYOR'S OFFICE

T245

1/4 S23/S24

RBW

1958

NEW BTs 11" W FIR SCRIBED
1/4 S23 CS BT ON D.B.
N66°W, 32.2 FT

9" D. FIR
" 1/4 S24 CS BT " P.B
S 31° E, 70

7" D. FIR
" 1/4 S23 CS BT " D.B
S 56 1/4° W, 18 5