

GOVERNMENT CORNER RESTORATION FORM

Township 26 S Range 1 E Sec. 21 County DOUGLAS

State OREGON Date 3/11/88 No. _____

Corner Designation

T 26 S R 1 E
S21 | S22
S28 | S27

Condition Report Only
 Not Found
 Renewed
 Unrecorded
 Surveyed In
 Referenced Out

Previous Renewals # 11

MONUMENT DETAIL

Monument(s) Found: (Condition and Source)

A 2 1/2 INCH DIAMETER BRASS CAP MARKED AS AT RIGHT ON A 2 INCH DIAMETER IRON PIPE LOOSELY SET AND LEANING EASTERLY PROTRUDES APPROXIMATELY 14 INCHES ABOVE GROUND

(MEASUREMENTS AS FOLLOW ARE TAKEN TO WHAT WOULD BE A PLUMB POSITION OF THE CAP.)

U.S. GENERAL LAND OFFICE SURVEY
T26S R1E

S21 | S22
S28 | S27

1928

Accessories Found:

FOUR ORIGINAL BEARING TREES ARE FOUND. A CHINQUAPIN, 8 INS. DIAM, NOW A 12 INCH D.B.H. CHINQUAPIN WITH A ROTTING PARTIALLY HEALED SINGLE BLAZE, NO SCRIBING VISIBLE, BEARS N 62 1/2° E, 13 1/2 FEET DISTANT (AGREES WITH RENEWAL #11 RECORD, ORIGINAL RECORD N 59° E, 12 1/2 FEET DISTANT). A FIR, 4 INS. DIAM, NOW A 9 INCH D.B.H. DOUGLAS FIR WITH A WELL HEALED DOUBLE BLAZE, BEARS S 58 1/2° E, 15 1/2 FEET DISTANT (AGREES WITH RENEWAL #11 RECORD, ORIGINAL RECORD S 56° E, 16 1/2 FEET DISTANT.) A MADRONE 6 INS. DIAM, NOW A 6 INCH D.B.H. MADRONE WITH A POSSIBLE PARTIALLY HEALED DOUBLE BLAZE WITH NO SCRIBING VISIBLE, BEARS S 31° W, 6 1/2 FEET DISTANT (AGREES WITH RENEWAL #11 RECORD, ORIGINAL RECORD S 44° W, 6 1/2 FEET DISTANT.) A FIR 4 INS. DIAM, NOW A 9 INCH D.B.H. DOUGLAS FIR WITH A FULLY HEALED DOUBLE BLAZE, NO SCRIBING VISIBLE, BEARS N 22° W, 6 1/2 FEET DISTANT (BEARING AGREES WITH RECORD IN RENEWAL #11 AND DISTANCE AGREES WITH ORIGINAL RECORD). TWO BOAT SPIKES SET AS REFERENCES IN RENEWAL #11 ARE FOUND. A BOAT SPIKE IN BASE OF A 24" DOUGLAS FIR NOW A 37 INCH D.B.H. DOUGLAS FIR BEARS N 44° W, 47 1/2 FEET DISTANT (AS PER RECORD). A BOAT SPIKE IN THE BASE OF A 34" INCENSE CEDAR NOW A 42 INCH D.B.H. INCENSE CEDAR BEARS S 49° W, 43 1/2 FEET DISTANT (RECORD S 50° W, 42 1/2 FT. DISTANT).

#154

C.S. File No. 62/50-11

RENEWAL

Monument Set (Procedure and Description)

Monument Detail

BEARINGS AND DISTANCES AGREE WELL WITH RECORD WHEN MEASURED FROM PLUMB POSITION OF FOUND MONUMENT.
MONUMENT IS THEREFORE STRAIGHTENED UP TO RESTORE IT TO A PLUMB POSITION AND A 2 FOOT DIAMETER 1 FOOT TALL MOUND OF STONE IS BUILT AROUND THE PROTRUDING FOUND MONUMENT.


NA

* ROAD CONSTRUCTION DID NOT DISTURB MONUMENT LOCATION.

New Accessories

NONE

Sketch of Monument, Accessories, and General Area

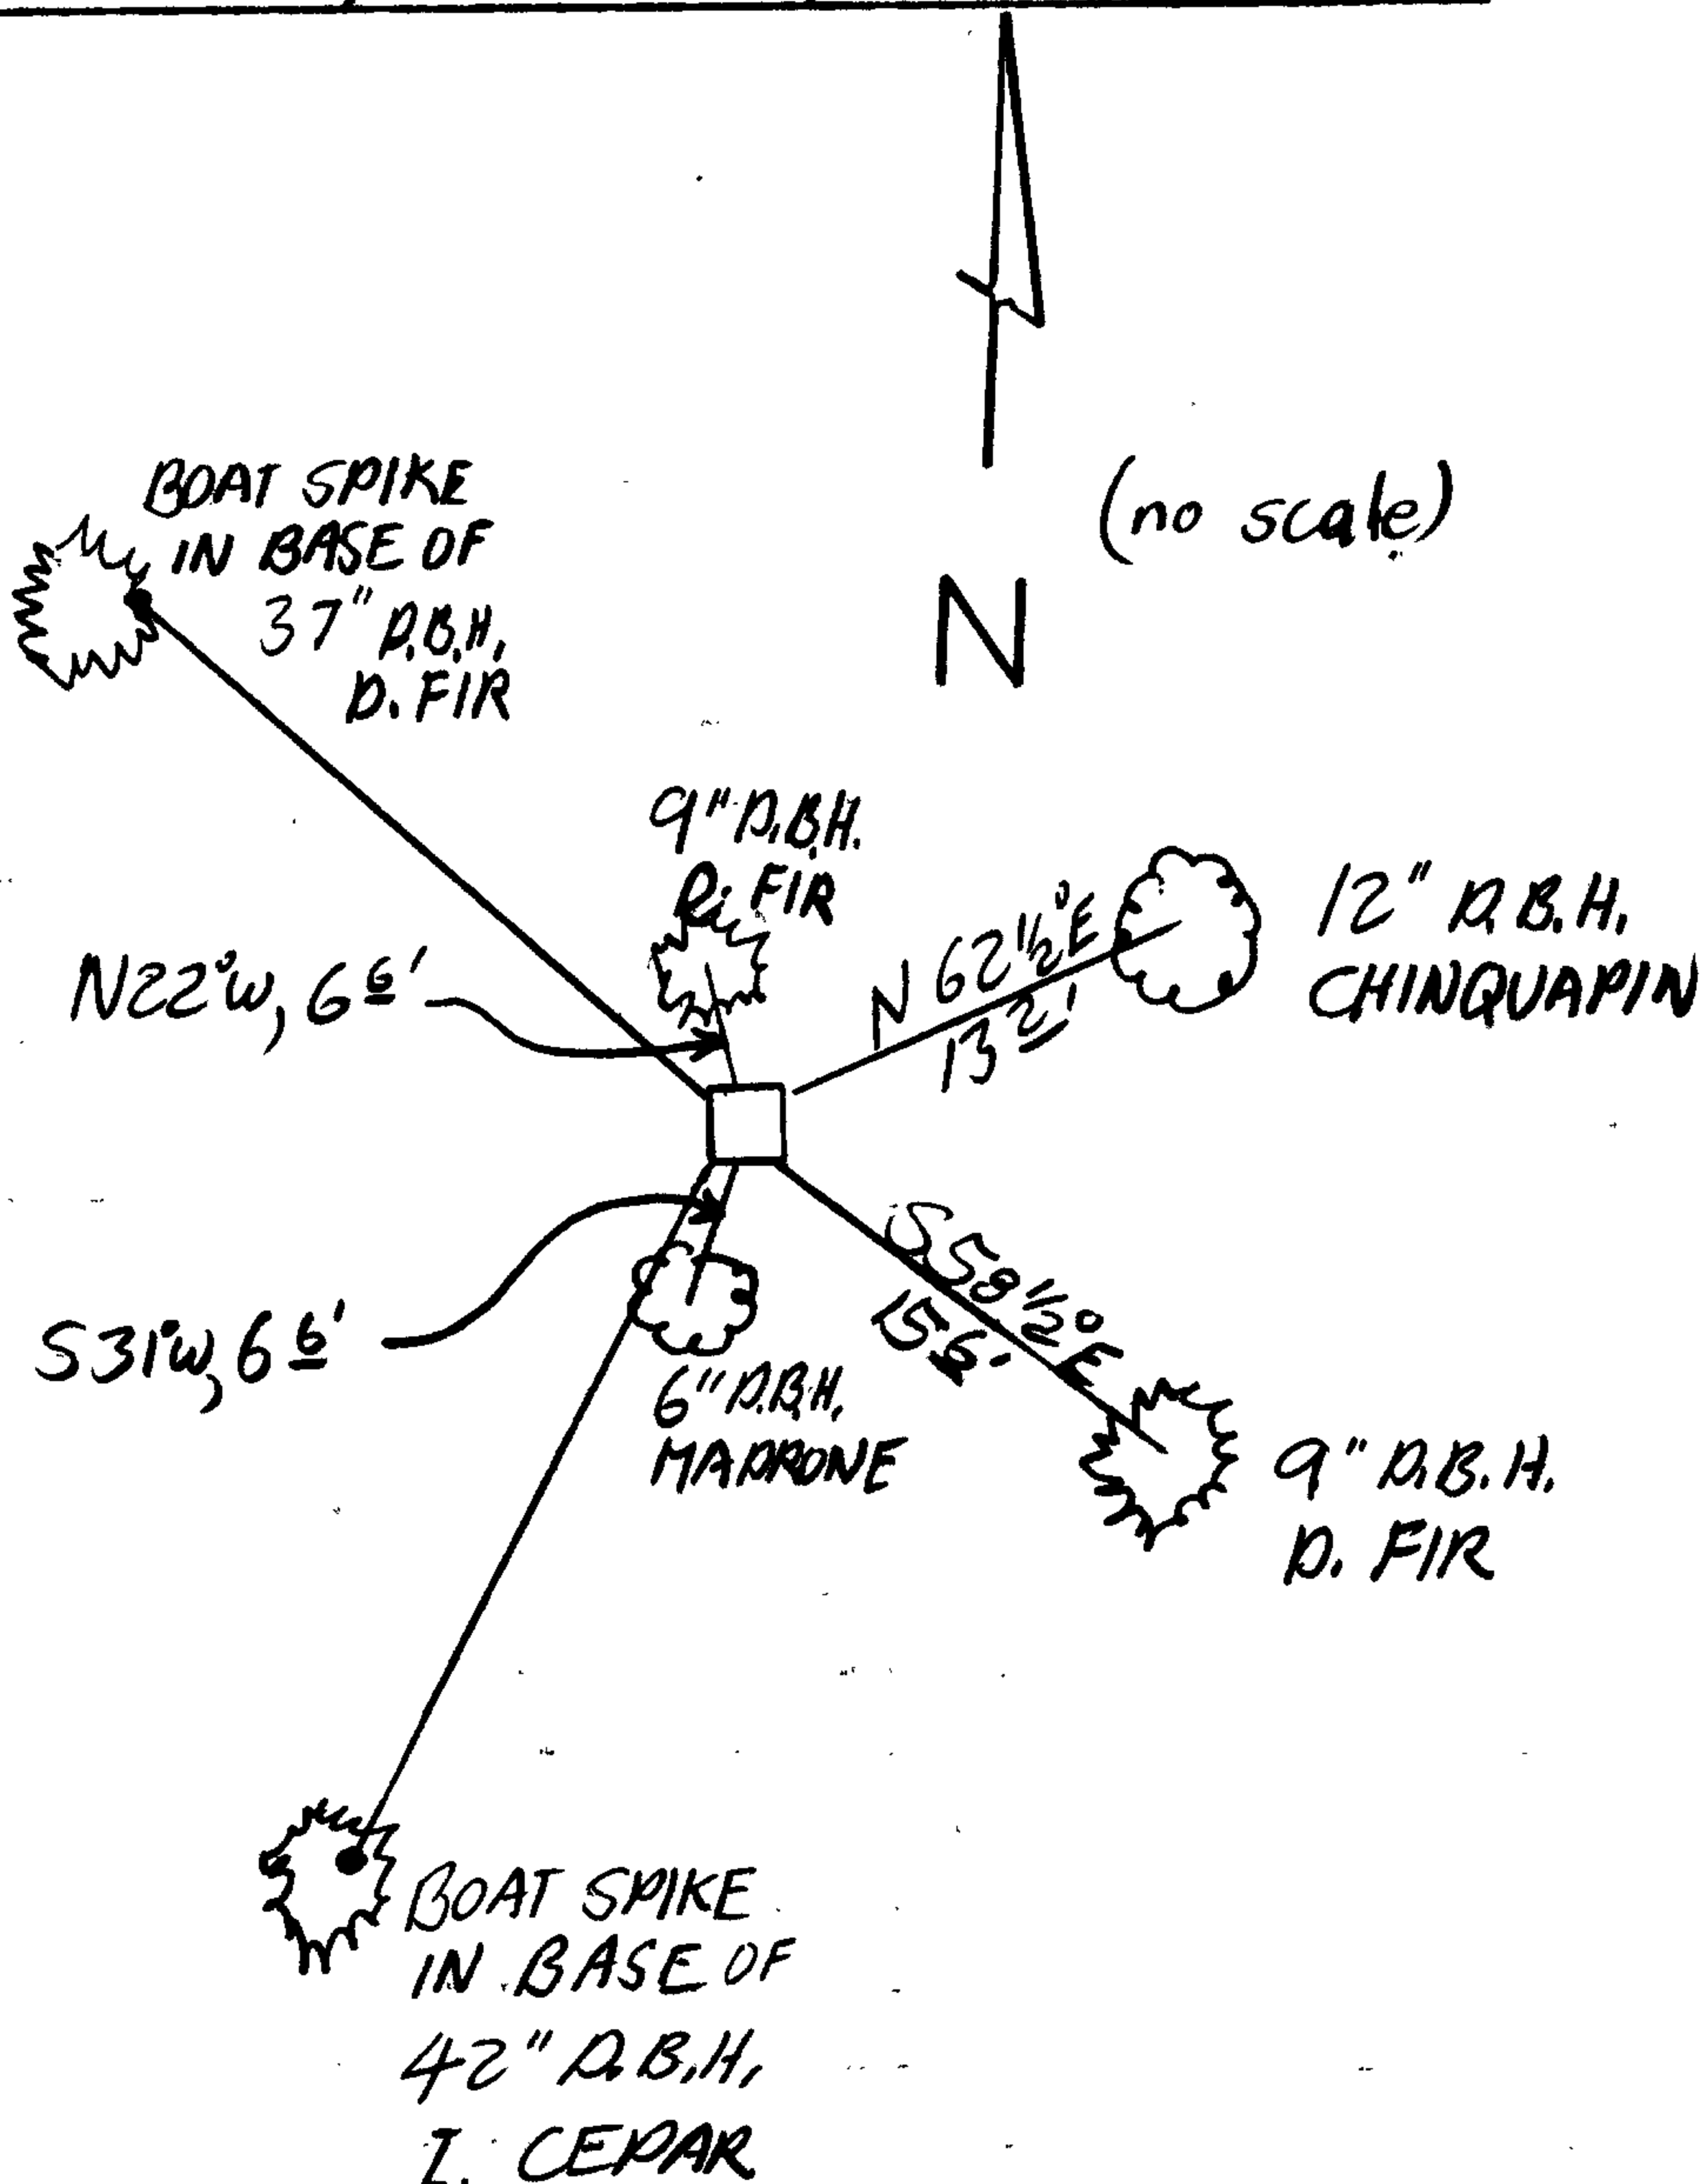

Location & Comments

MONUMENT IS APPROX. 35' NORTH WESTERLY FROM A LOGGING UNIT ACCESS ROAD AND NEAR THE TOP OF A MODERATE NORTHWESTERLY SLOPE.

Comp. Declin. 18°E
Agency DCSO
Party Chief STEPHEN JOHN FLAUBE
Notekeeper Stephen John Flaube
Witnesses R. W. SMITH

Address

Surveyor's Seal

REGISTERED PROFESSIONAL LAND SURVEYOR

Larry E. Monrean

OREGON
JULY 13, 1979
LARRY E. MONREAN
#1830

RD. NOT BUILT AS OF
11-81 GP
NOT BUILT 6-16-83

PAGE 2

AN ORIGINAL BT, A 4" NOW 8" D. FIR BEARS 9" ^{DOUBT}
S 58° E 15 FT. (REG. S 56° E 16 FT.)
ALIVE AND WELL-HEALED. DB

AN ORIGINAL BT, A 6" NOW 6" MADRONE STILL 6"
BEARS S 31° W 6 FT. (REG. S 44° W 6 FT.)
ALIVE WITH NO BLAZES OR MARKINGS
VISIBLE. POSSIBLE PHOT. NO SCRIBING

AND AN ORIGINAL BT, A 4" NOW 8" D. FIR BEARS 9"
N 22° W 7 FT. (REG. N 30° W 6 FT.)
ALIVE AND WELL-HEALED.

DUE TO IMPENDING ROAD CONSTRUCTION, WE
REFERENCE THIS CORNER AS FOLLOWS:

WE SET:

A BOATSPIKE IN THE BASE OF A 3" 42"
INCENSE CEDAR BEARS S 49° W 43 FT.

AND A BOATSPIKE SET IN THE BASE OF A 37"
24" D. FIR BEARS N 44° W 47 FT.

WE LEAVE THE BRASS CAP IN PLACE.

COMPASS DECLINATION 20° EAST

12-20-76
C.S. FILE NO. 59/20
KAREN CHANEY
Mike Tompkins

S-886-D-N-N-2071-110

26-1E $\frac{21}{22}$
 $\frac{28}{27}$

12-20-76

$\frac{21}{22}$ $\frac{28}{27}$ T265 R1E

(CORNER REFERENCED OUT FOR
ROAD CONSTRUCTION)

FOUND:
A 2" IRON PIPE ^{NOT} FIRMLY SET AND
EXTENDING 14" ABOVE GROUND WITH
2 1/2" BRASS CAP ATTACHED, MARKED:

U.S. GENERAL LAND OFFICE SURVEY
T265 R1E

$\frac{31}{32}$ $\frac{32}{32}$
 $\frac{328}{327}$
1928

AND
2' DIAM. MOUND
OF STONE 12" TALL

FROM WHICH:

AN ORIGINAL BT, AN 8" NOW 12" V
CHINGUAPIN BEARS N 62 1/2° E 13 FT.
(REG. N 59° E 12 FT.), ALIVE WITH ROTTING
FACE PARTIALLY VISIBLE, NO SCRIBING
VISIBLE. SB

S-886-D-N-N-2071-110

File No. 59/20 Page 1

C.S. 62/50-11

B.O.S

REFERENCES

BOAT SPIKE IN BASE OF 34" INCENSE LEAD

BEARS S 50° W 42' FT.

~~44° @ 15' (42')~~

B. SPIKE IN BASE OF "D. F.

BEARS N 44° W 47'

~~52° @ 23' (47')~~

19205

52.2

18410

18410

46025

46050 6