

GOVERNMENT CORNER RESTORATION FORM

Township 25S Range 5W Sec. 8 County DOUGLAS

State OR Date 6/29/88 No. \_\_\_\_\_

Corner Designation

1/4  
58 | 59

- Condition Report Only
- Not Found
- Renewed
- Unrecorded
- Surveyed In
- Referenced Out

Previous Renewals #10, #54, 1964 BLM D. RESURVEY

MONUMENT DETAIL

Monument(s) Found: (Condition and Source)

FO 1" O.D. I.P. FLUSH WITH GROUND.  
TOP WAS BROKEN OFF. A SMALL  
4" SECTION OF 1" O.D. I.P. FOUND NEAR  
CORNER. (PROBABLY 1" I.P. PER REN  
#10) ALSO BC/I.P. PER REN #54  
NOT FOUND

N/A

Accessories Found:

ALL ORIGINAL BT'S GONE

24" NOW 30" DIA. 6 FT HIGH D. FIR STUMP WITH A BURNT OUT BLAZE  
NO SCRIBING VISIBLE, BEARS N 26° W, 6.0 FT (REC. N 26° W,  
5.3 FT DISTANCE IS A FACE MEASUREMENT). PER REN #10

36" NOW 36" DIA. 3 FT HIGH MADRONE STUMP IN A CLUSTER  
OF SMALL MADRONES, STUMP HAS A ROTTED OUT BLAZE, NO SCRIBING  
VISIBLE, BEARS S 72 3/4° W, 29.7 FT (AGREES WITH REC.) PER REN #10

13" NOW 18" DIA. W. OAK WITH A FULLY HEALED SINGLE BLAZE,  
BEARS N 74° W, 70.6 FT (AGREES WITH 1964 BLM D. RESURVEY)  
PER REN #54

34" NOW 34" DIA. DOWN AND ROTTING OAK WITH VISIBLE SCRIBING  
" | | c " BEAR S 8° E, 76.0 FT (AGREES WITH REC.)  
PER REN #54

#147 x

RENEWAL

Monument Set (Procedure and Description)

POSITION OF 1" O.D. I.P. REFERENCED  
 AND A DC SO BC/IP MEASURING  
 1/4" O.D. BY 32" LONG SET IN  
 REFERENCED POSITION. FD 1" O.D.  
 I.P. DUG OUT TO 30" AND BROKE OFF,  
 REMAINING I.P. IMMOVABLE AND  
 LEFT IN GROUND. 1" BY 30" LONG PIECE OF  
 I.P. RESET ALONG NORTH SIDE OF DC SO  
 BC/IP. PROTRUDING 4" ABOVE GROUND.  
 DC SO BC/IP PROTRUDES 5" ABOVE GROUND.

Monument Detail

DOUGLAS COUNTY SURVEYORS  
 T 255


1/4 S 8/S 9  
 R 5 W  
 1988  
 OFFICE

New Accessories

7" MAPLE DOUBLE BLAZED AND SCRIBED " 1/4 S 9 CS BT"  
 BEARS N 61° E, 43.3 FT.

18" D. FIR DOUBLE BLAZED AND SCRIBED " 1/4 S 9 CS BT"  
 BEARS S 57° E, 34.3 FT.

Sketch of Monument, Accessories, and General Area

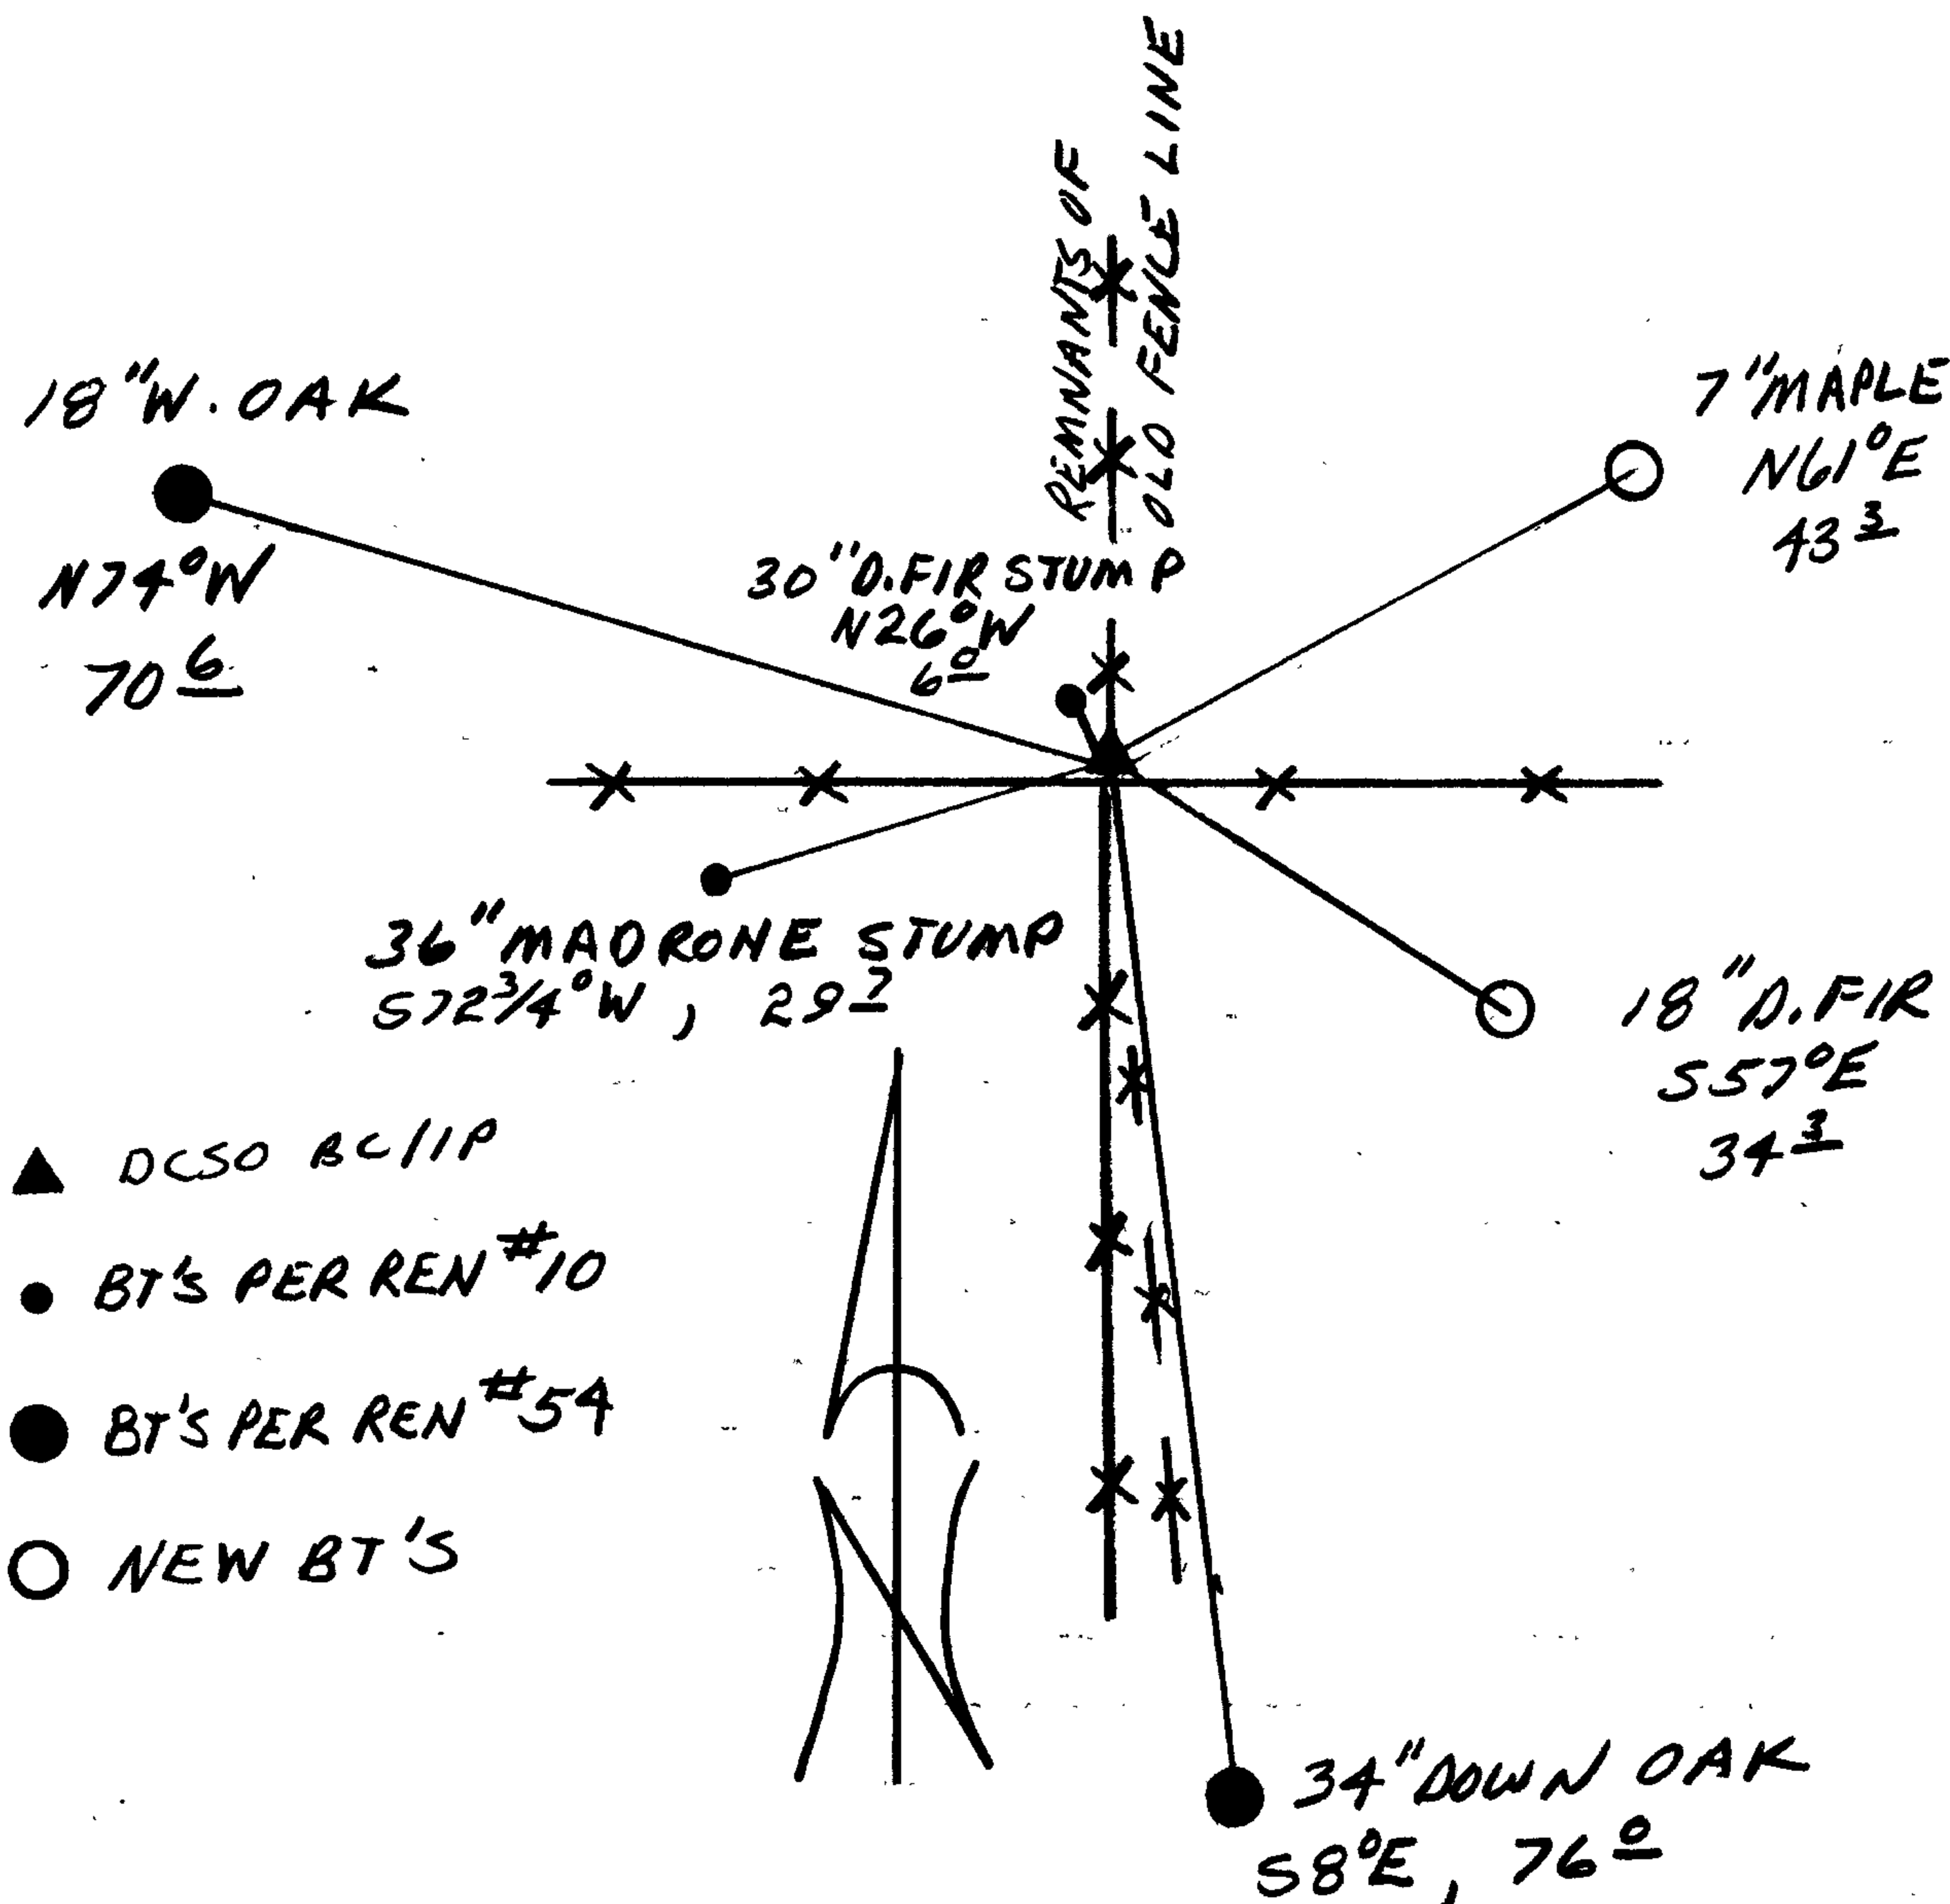

Location & Comments

Comp. Declin. 18° E  
 Agency DC SO  
 Party Chief RANDALL W SMITH  
 Notekeeper Randall W Smith  
 Witnesses STEPHEN J FLAUSE

Address

Surveyor's Seal

REGISTERED  
 PROFESSIONAL  
 LAND SURVEYOR

*Larry E. Monrean*

OREGON  
 JULY 13, 1979  
 LARRY E. MONREAN  
 #1830