

GOVERNMENT CORNER RESTORATION FORM

Township 27S Range 1W Sec. 20 County DOUGLAS

State OR Date 6/29/88 No. _____

Corner Designation

S20 | S21
S29 | S28

- _____ Condition Report Only
- _____ Not Found
- Renewed
- _____ Unrecorded
- _____ Surveyed In
- _____ Referenced Out

Previous Renewals #60

MONUMENT DETAIL

Monument(s) Found: (Condition and Source)

DLSO BC/IP SET PER REN #60
IS GONE. ORIGINAL 15"X12"X4"
STONE WITH 2 NOTCHES ON A SIDE,
AND 4 NOTCHES ON ANOTHER SIDE
FOUND LAYING FLAT ON TOP OF
GROUND LOOSE AND APPARENTLY OUT OF
POSITION (CORNER POSITION AS DETERMINE
BY BT'S IS 2 FT SOUTHERLY FROM FOUND
POSITION OF STONE).

N/A

Accessories Found:

ORIGINAL BT'S
19" NOW 20" DIA. 10 FT HIGH D. FIR STOB WITH A PREVIOUSLY OPENED
BLAZE AND SCRIBING VISIBLE "T27S" BEARS N34°W, 66.0 FT. (AGREES
WITH RECORD).
36" NOW 42" DIA. DOWN D. FIR WITH A PREVIOUSLY OPENED BLAZE,
ILLEGIBLE SCRIBING VISIBLE, BEARS S60°E, 52.8 FT TO ROOT
HOLE (AGREES WITH RECORD).
24" NOW 30" DIA. 1 1/2 FT HIGH BURNT D. FIR STUMP, NO BLAZES
OR SCRIBING VISIBLE, BEARS N29°E, 70.6 FT (AGREES WITH RECORD).
30" PINE NOW 30" DIA. 1 1/2 FT HIGH ROTTED TIPPED OUT STUMP (UNABLE TO IDENTIFY
SPECIES) BEARS S86°W, 24.4 FT TO ROOT HOLE. (AGREES WITH ORIG. RECORD).
BT'S PER REN #60
4" NOW 12" DIA. D. FIR WITH A FULLY HEALED DOUBLE BLAZE, BEARS N7 1/2°E,
22.6 FT (REC. N9°E, 23.0 FT, DIST. TO CENTER OF TRUNK).
6" NOW 12" DIA. D. FIR WITH A FULLY HEALED DOUBLE BLAZE, BEARS N59 1/2°E,
9.4 FT (AGREES WITH RECORD)
6" NOW 8" DIA. MAPLE WITH A PARTIALLY HEALED SINGLE BLAZE, SCRIBING
VISIBLE "R1W S28" BEARS S3°E, 16.1 FT (REC. S3°E, 15.7 FT, DIST. IS
TO CENTER OF TRUNK).
7" NOW 11" DIA. MAPLE WITH A PARTIALLY HEALED DOUBLE BLAZE, SCRIBING
VISIBLE "1W S29 CS BT" BEARS S61°W, 20.4 FT (REC. S61°W, 20.1 FT
DIST. TO CENTER OF TRUNK).

#1954

C.S. File No. 62/52

RENEWAL

Monument Set (Procedure and Description)

CORNER POSITION DETERMINED FROM ORIGINAL AND REN#60 BEARING TREES. A ALSO BC ON A 1 1/4" O.D. BY 32" LONG I.P. IS SET AND PROTRUDES 6 IN ABOVE GROUND. THE ORIGINAL CORNER STONE IS SET ALONG SOUTH EDGE OF BC/IP WITH 2 NOTCHES ON S SOUTH AND 4 NOTCHES ON EAST EDGE. TOP OF STONE PROTRUDES 6 IN ABOVE GROUND AND MEASURES 9" BY 3" WIDE. A 2 1/2 FT DIA. MOUND OF STONE SURROUNDS CORNER.


Monument Detail

DOUGLAS COUNTY SURVEYOR
T275
S20|S21
S29|S28
RIW
1988

New Accessories

NONE

Sketch of Monument, Accessories, and General Area

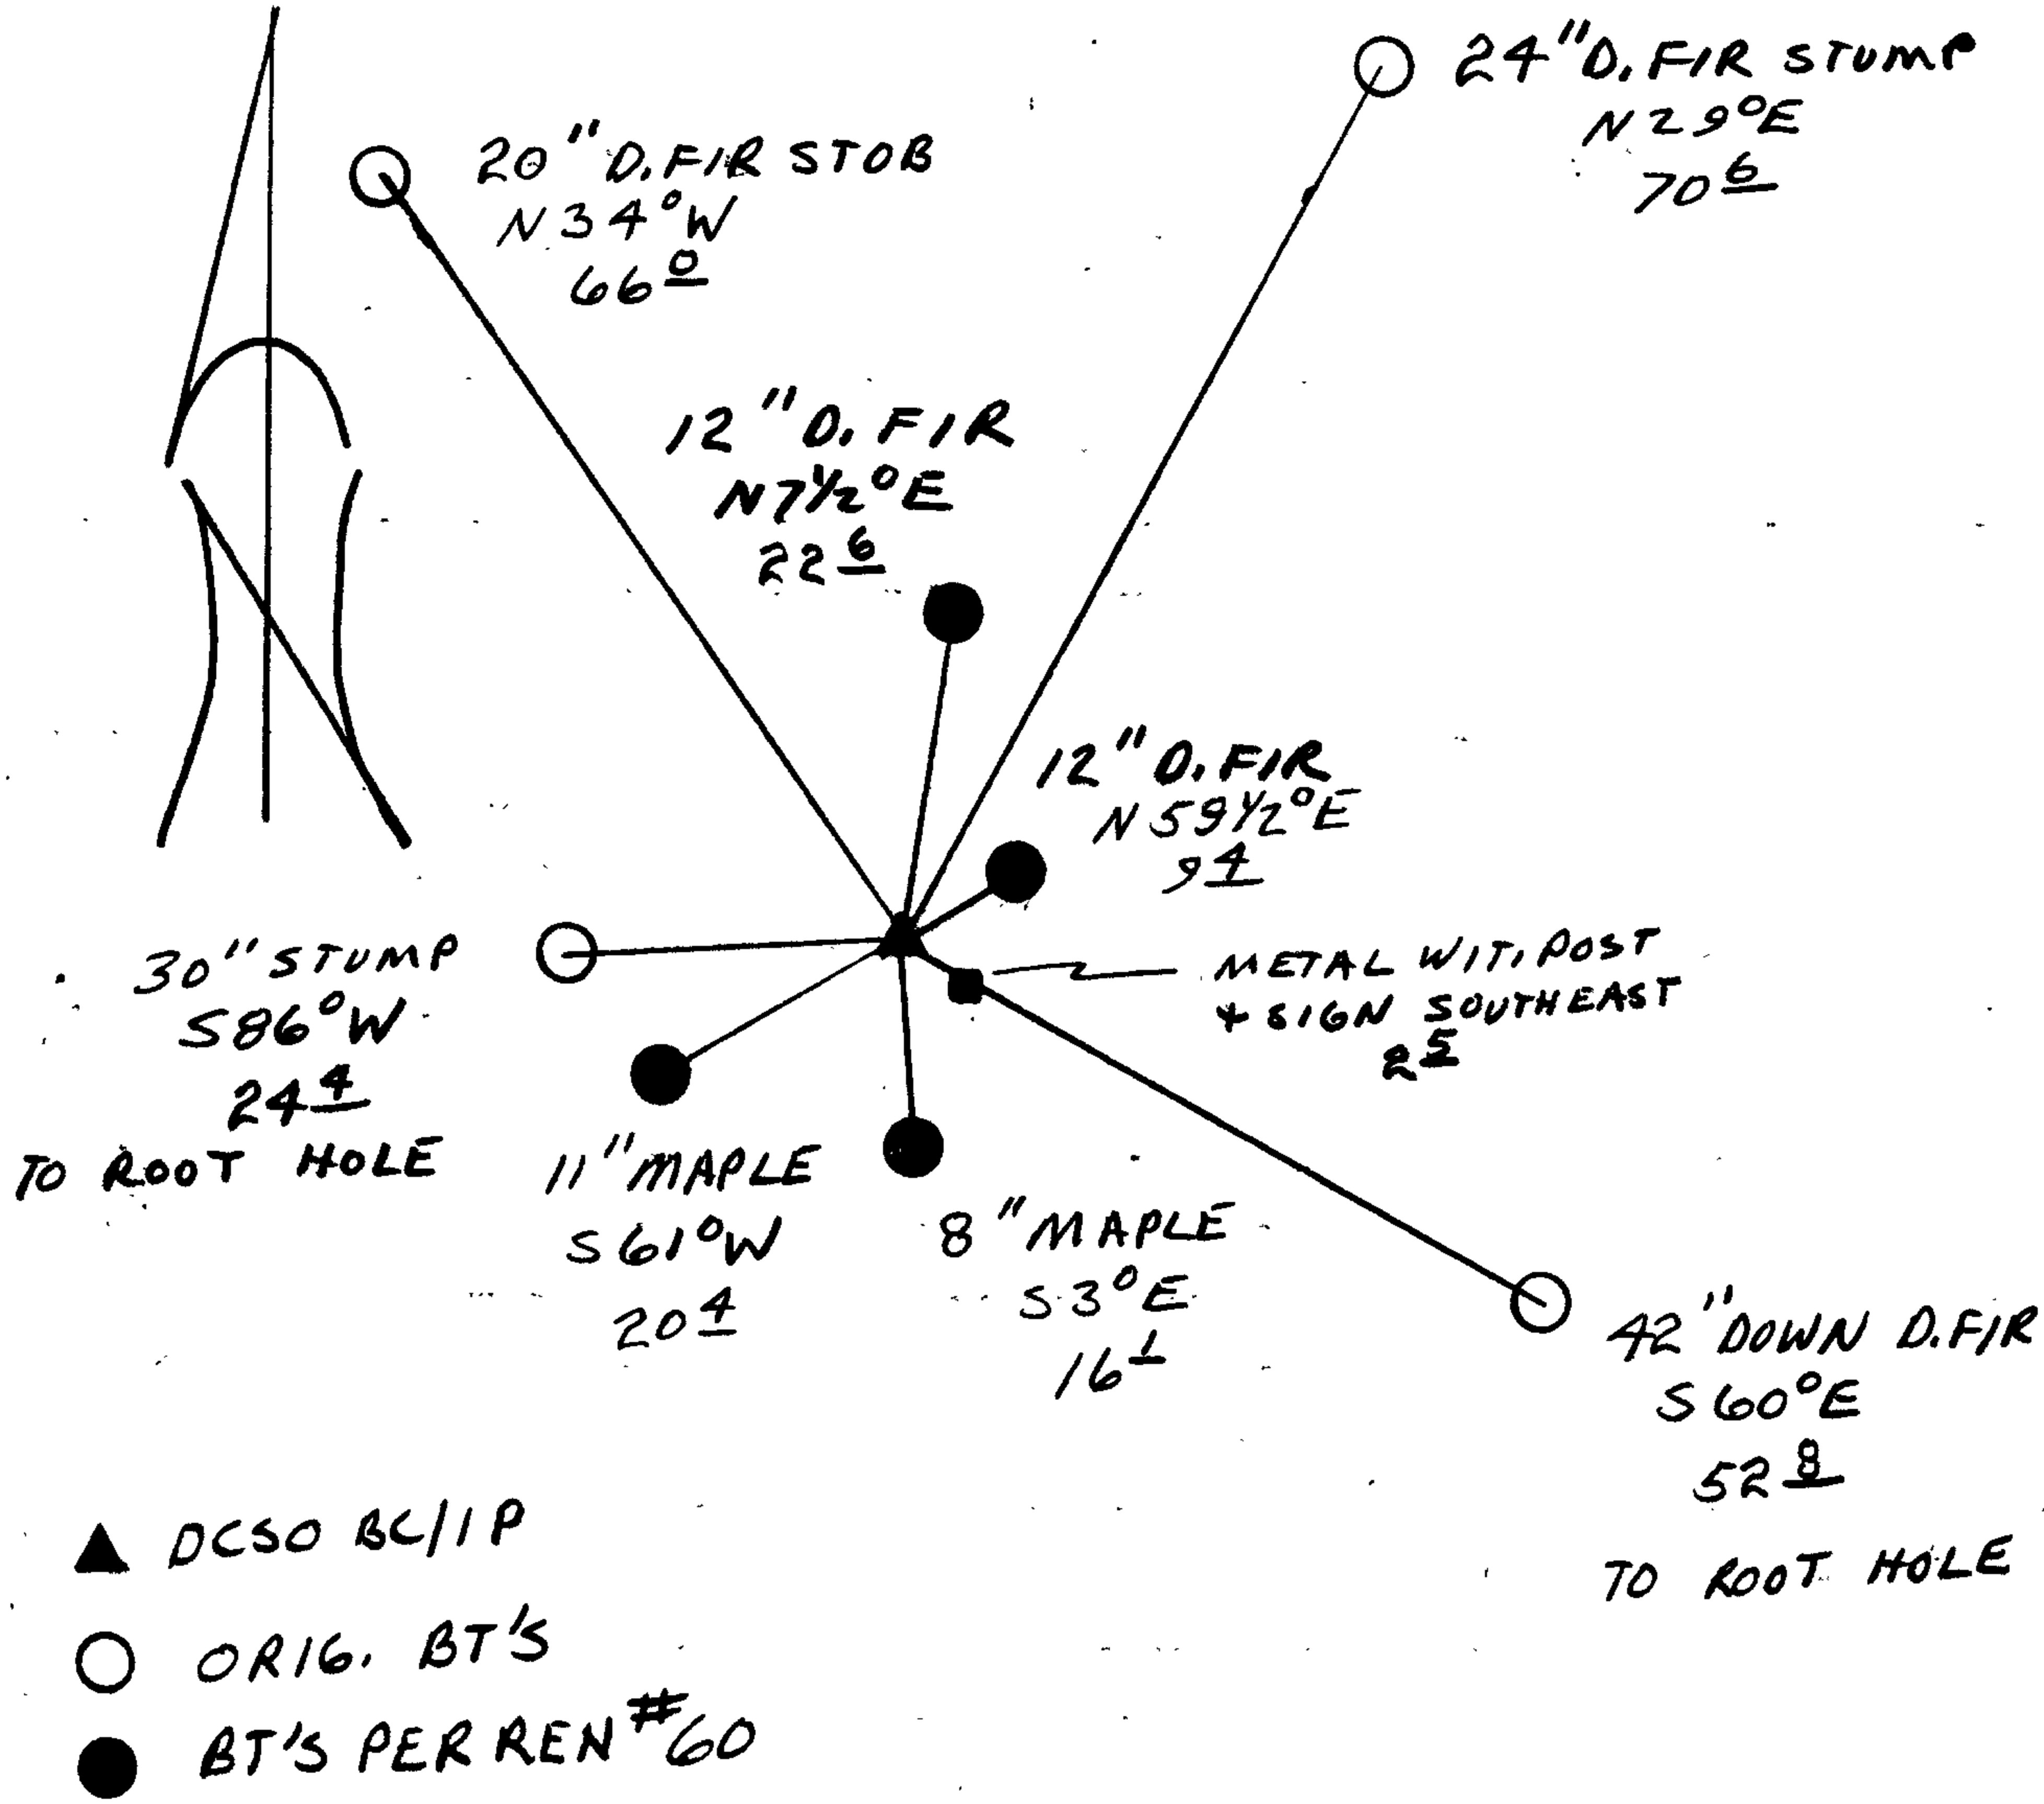

Location & Comments

CORNER IS APPROX 60 FT NORTH OF FOREST SERVICE RD# 2792-086

Comp. Declin. 18°E
 Agency DCSO
 Party Chief RANDALL W SMITH
 Notekeeper Randall W Smith
 Witnesses STEPHEN J FLAUSE

Address

Surveyor's Seal

REGISTERED PROFESSIONAL LAND SURVEYOR

Larry E. Monrean

OREGON
 JULY 13, 1979
 LARRY E. MONREAN
 #1830