

GOVERNMENT CORNER RESTORATION FORM

Township 28S Range 6W Sec. 17 County DOUGLAS

State OR Date 4/28/88 No. _____

Corner Designation (POINT OF SURVEY)

S18	S17
S19	S20

- Condition Report Only
- Not Found
- Renewed
- Unrecorded
- Surveyed In
- Referenced Out

Previous Renewals #21, #124

Monument(s) Found: (Condition and Source)

A 2 1/2" DIA. DCSSO BRASS CAP ON A
1 1/2" DIA. IRON PIPE PROTRUDING
10 IN. ABOVE A 3 FT DIA. MOUND
OF STONE. PER REN #124

3/4" I.R. PROTRUDING 1 IN. ABOVE
GROUND. SOURCE UNKNOWN. BEARS
N 46°W, 4.2 FT FROM DCSSO BC/IR.
(RECORD N 44°W, 5.0 FT PER. REN #124)

1" IRON PIPE PER REN #21 NOT FOUND

COUNTY SURVEYORS OFFICE
T28S R6W

S18	S17
S19	S20

1962

Accessories Found:

MEASUREMENTS TAKEN TO DCSSO BC/I.R.
ORIGINAL BT'S LOOKED FOR, NONE FOUND.

NORTH END OF GABLE ON OLD BARN BEARS S 66 3/4° E, (AGREES WELL WITH RECORD)
PER REN # 21.

1 1/4 FT LONG BY 8 FT WIDE BY 4 FT HIGH AT HIGHEST POINT ROCK
OUTCROP, BEARS N 44 1/2° W, 191.5 FT TO SOUTH EDGE (AGREES
WELL WITH RECORD) PER REN # 21.

1 1/4 FT LONG BY 4 FT WIDE BY 6 1/2 FT HIGH AT HIGHEST POINT ROCK OUTCROP
BEARS S 84 1/2° E, 783.0 FT TO HIGHEST POINT (RECORD S 84 1/2° E, 780 FT)
PER REN # 21

3 1/2 FT BY 3 FT BY 8 IN HIGH ROCK OUTCROP WITH CHISLED "T" ON
TOP BEARS N 81° W, 54.0 FT TO "T" (RECORD N 79° W, 54.0 FT) PER REN #124

CHISLED BO ON ROCK WEST OF CORNER, NOT FOUND PER REN #124

#181x

RENEWAL

Monument Detail

Monument Set (Procedure and Description) N/A


DCSO BC/1P IS A POINT OF SURVEY AS DETERMINED BY B.B. IRVING IN REN#21 AND PERPETUATED IN REN#124. SURVEY POINT SET BY SINGLE PROPORTION, NOT ACCORDING TO THE PRESCRIBED METHODS OF THE MANUAL OF SURVEY INSTRUCTION TO REESTABLISH A FOUR WAY SECTION CORNER. WE PERPETUATE THIS POSITION AS AN IMPORTANT SURVEY POINT THAT HAS BEEN IN EXISTENCE SINCE 1922. (SEE DCSO RENEWAL RECORDS #21, VOL 3 Pg 190A, AND C.S. FILE #5/14).

N/A

New Accessories

NONE

Sketch of Monument, Accessories, and General Area

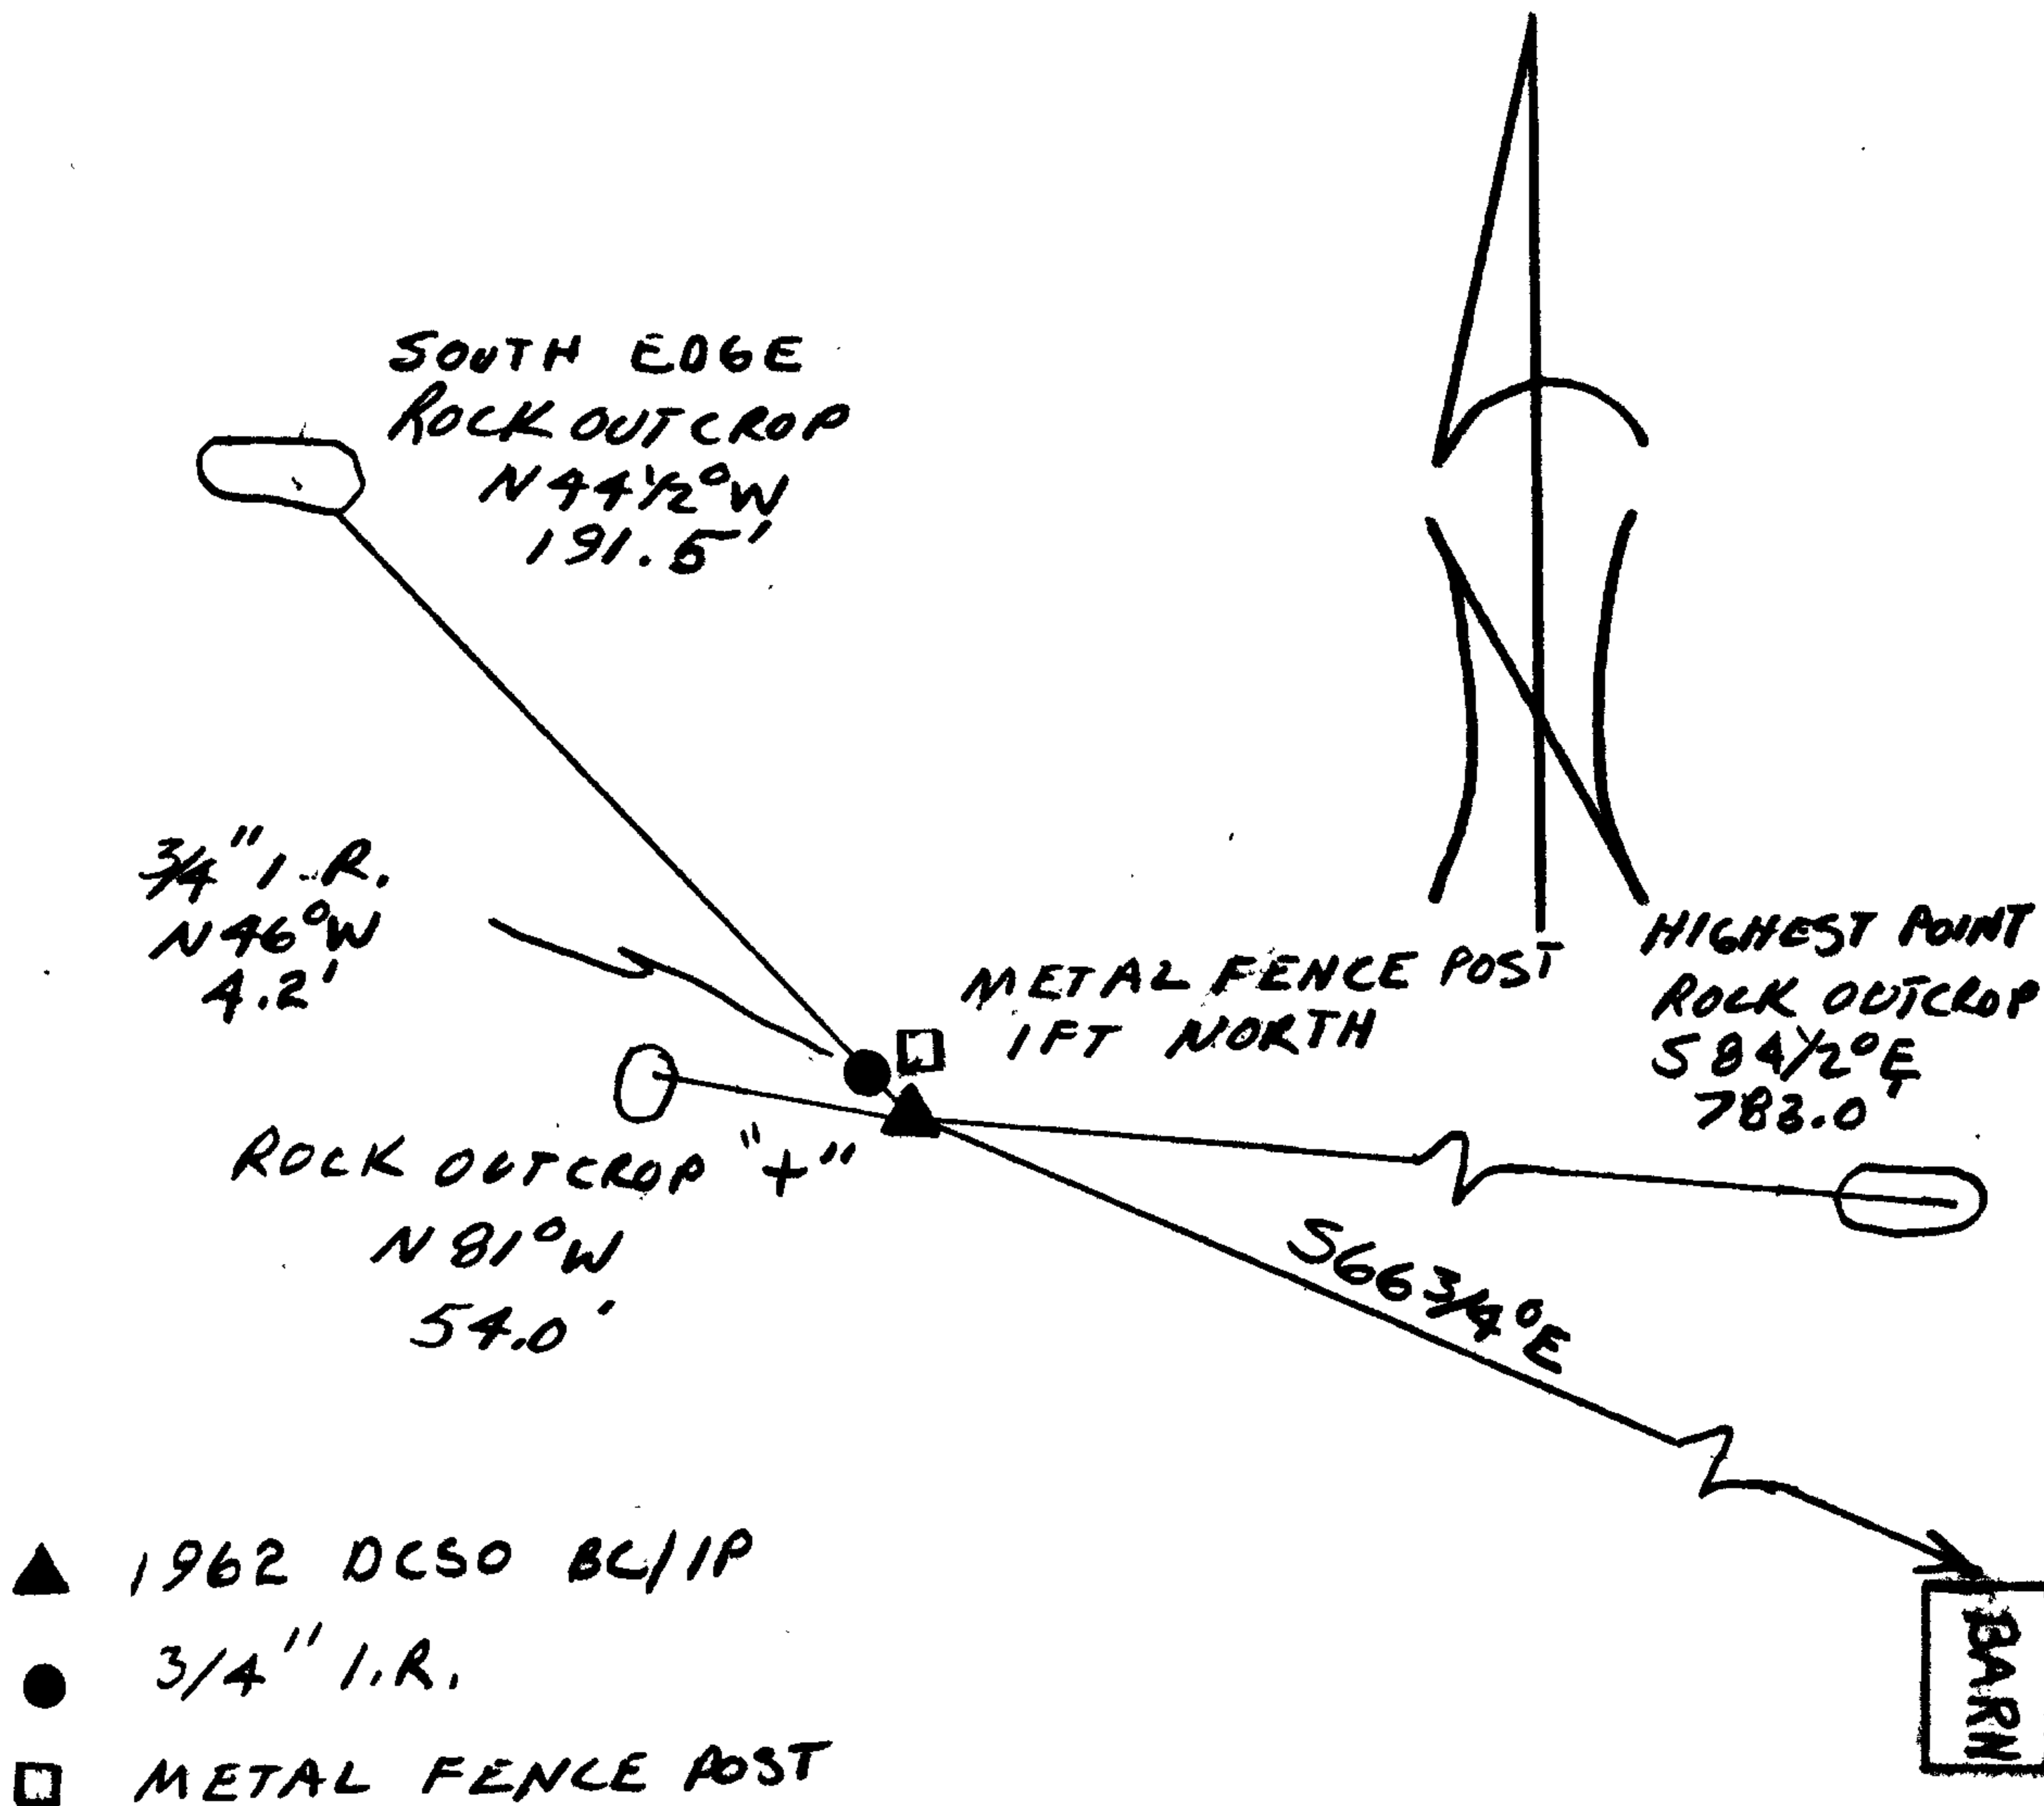

Location & Comments

CORNER LIES IN AN OPEN PASTURE.

Comp. Declin. 18° E
Agency DCSO
Party Chief RANDALL W SMITH
Notekeeper Randall W Smith
Witnesses STEPHEN J FLAUSE

Surveyor's Seal

REGISTERED PROFESSIONAL LAND SURVEYOR

Larry E. Monrean
OREGON
JULY 13, 1979
LARRY E. MONREAN
#1820