

GOVERNMENT CORNER RESTORATION FORM

Township 255 Range 6W Sec. 8 County DOUGLAS

State OR Date SEPT 1, 1988 No. \_\_\_\_\_

Corner Designation

S8 | S9  
S17 | S16

- Condition Report Only
- Not Found
- Renewed
- Unrecorded
- Surveyed In
- Referenced Out

Previous Renewals # 96

Monument(s) Found: (Condition and Source)

2 1/2" DIA. ALSO BRASS CAP ON  
A 2 3/8" O.D. IRON PIPE, PROTRUDING  
17 IN ABOVE GROUND. IRON PIPE  
IS BENT TO GROUND AND POINTING  
EAST OF PLUMB POSITION (PER REN #96)  
BASE OF IRON PIPE IS FIRMLY  
SET AND PLUMB.

COUNTY SURVEYORS OFFICE

T 255

S8 | S9  
S17 | S16

R 6W

1962

Accessories Found:

BEARINGS AND DISTANCES TAKEN TO PLUMB POSITION OF ALSO BC/1P  
NO ORIGINAL BEARING TREE'S FOUND

BT'S PER REN #96

16" NOW 14" DIA. 2 1/2 FT HIGH ROTTING D. FIR STUMP WITH SCRIBING  
VISIBLE "T255 R6W S8 CS BT" BEARS N32°W, 10.3 FT (AGREES WITH REC.)

15" NOW 19" DIA. W. OAK WITH A FULLY HEALED DOUBLE BLAZE  
BEARS S85°W, 51.8 FT (REC. S87°W, 51.8 FT).

14" NOW 20" DIA. W. OAK WITH A FULLY HEALED DOUBLE BLAZE  
BEARS S20°E, 21.5 FT (AGREES WITH REC.)

9" NOW 12" DIA. W. OAK WITH A FULLY HEALED DOUBLE BLAZE  
BEARS N83°E, 49.5 FT (REC. N85°E, 49.5 FT).

#190x

RENEWAL

Monument Detail

Monument Set (Procedure and Description)


PLUMB POSITION OF DC SO 1962 BC/IP REFERENCED. 1962 DC SO BC/IP MEASURES 36 IN LONG IS STRENGTHENED AND SET AT REFERENCED PLUMB POSITION. BC/IP NOW PROTRUDES 5 IN. ABOVE GROUND.

N/A

New Accessories

10" DIA. D. FIR DOUBLE BLAZED AND SCRIBED "T255 R6W S8 CS BT" BEARS N 9°W, 30.7 FT.

Sketch of Monument, Accessories, and General Area

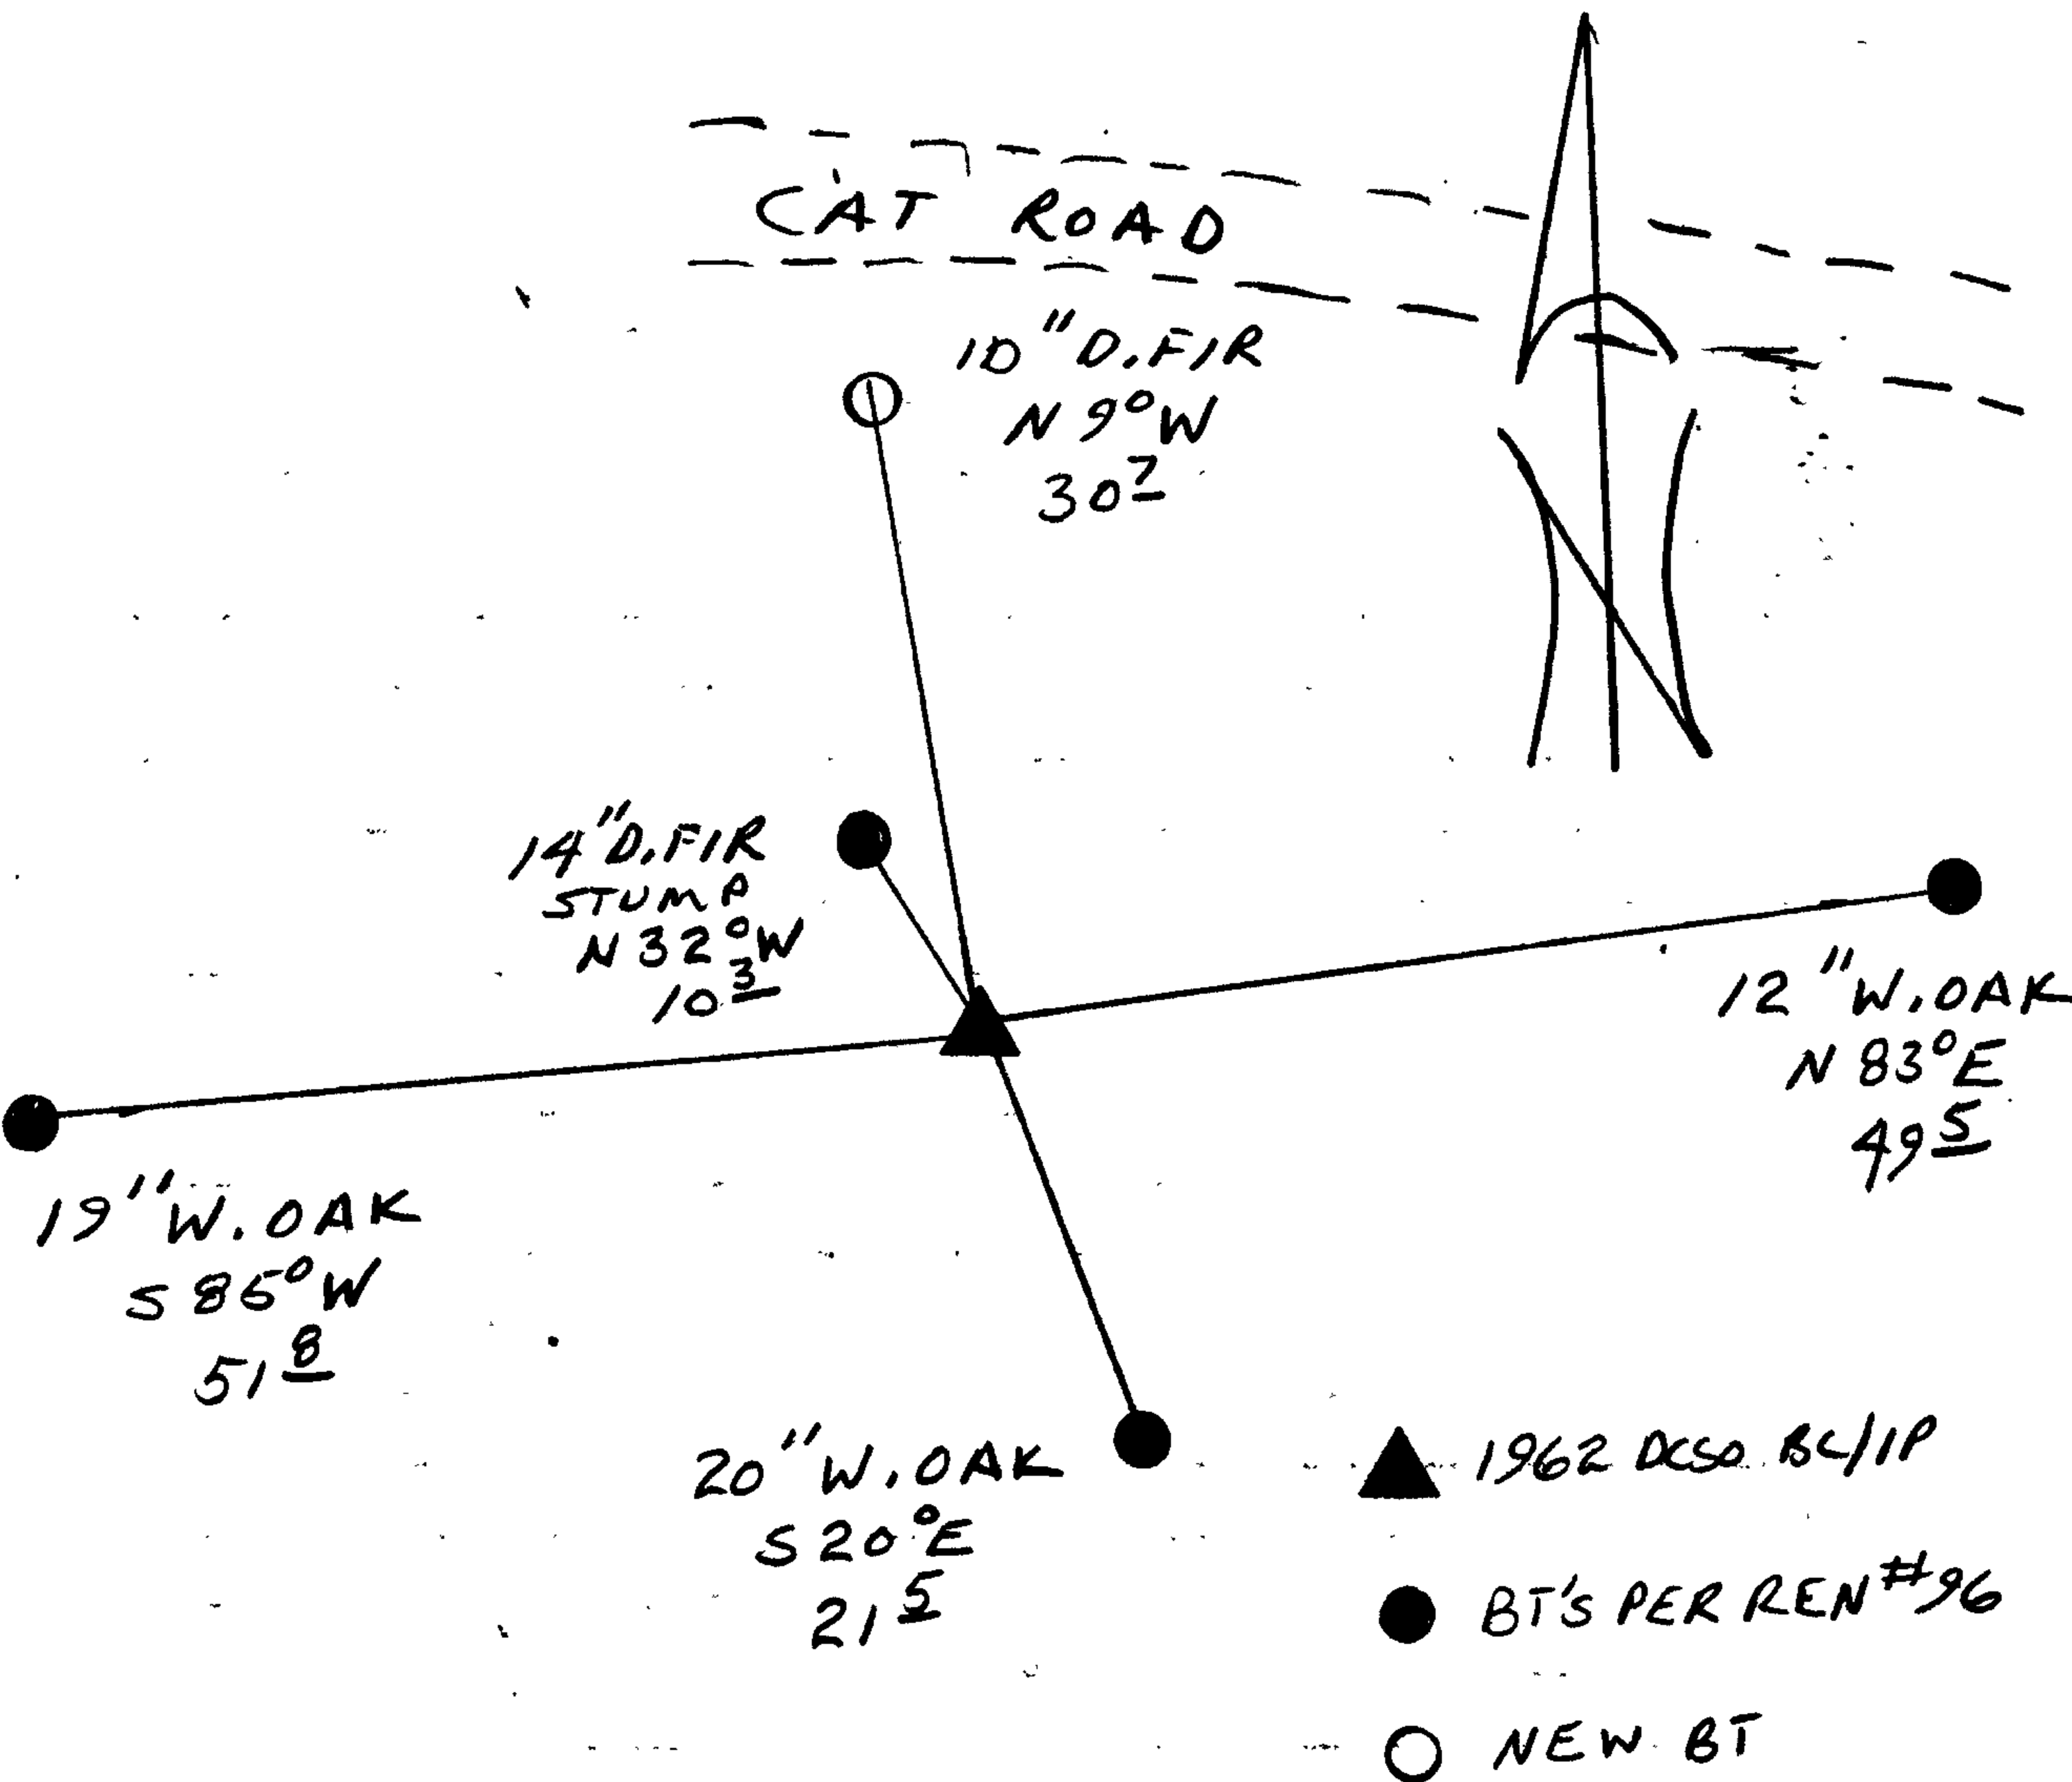

Location & Comments

Comp. Declin. 18 1/2° E  
Agency DC SO  
Party Chief RANDALL W SMITH  
Notekeeper Randall W Smith  
Witnesses STEPHEN J. FLAUSE

Address

Surveyor's Seal

REGISTERED PROFESSIONAL LAND SURVEYOR

*Larry E. Monrean*

OREGON  
JULY 13, 1979  
LARRY E. MONREAN  
#1830