

GOVERNMENT CORNER RESTORATION FORM

Township 22S Range 5W Sec. 9 County DOUGLAS

State OR Date 11/3/88 No. _____

Corner Designation

1/4 S9 | S10

- Condition Report Only
- Not Found
- Renewed
- Unrecorded
- Surveyed In
- Referenced Out

Previous Renewals #88, #117

Monument(s) Found: (Condition and Source)

A FIRMLY SET 1/2" IRON ROD WITH EYE ON TOP PROTRUDES 6 IN. ABOVE GROUND, EYE BOLT LEANS 6 IN. WEST OF PLUMB. (SOURCE UNKNOWN)

N/A

Accessories Found:

BEARINGS AND DISTANCES TAKEN TO PLUMB POSITION OF EYE BOLT

6" NOW 30" DIA. ROTTING D. FIR SNAG WITH A PREVIOUSLY OPENED BLAZE, SCRIBING VISIBLE "Y4S" BEARS N56°W, 16.5 FT (AGREES WITH RECORD) ORIG. BT

3" NOW 9" DIA. MAORONE PARTIALLY ROTTED BLAZE OPENED AND SCRIBING "S10" FOUND. BEARS S49°E, 9.2 FT (RECORD S49°E, 10.0 DISTANCE IS A SLOPE MEASUREMENT) PER REN #117

MONUMENT DETAIL

#157x

RENEWAL

Monument Set (Procedure and Description)

A BRASS CAP, 3/4" PIPE MONUMENT WAS NOT SET CORNER LIES IN A STEEP ROCKY AREA WITH SHALLOW SOIL.

Monument Detail


N/A

New Accessories

6" DIA. MAPLE DOUBLE BLAZED AND SCRIBED "1/4 S10 CS BT" BEARS S6°W, 67.6 FT.

5" DIA. MADRONE BARK SCRIBED "1/4 S10 CS BT" BEARS N6°E, 22.2 FT.

Sketch of Monument, Accessories, and General Area

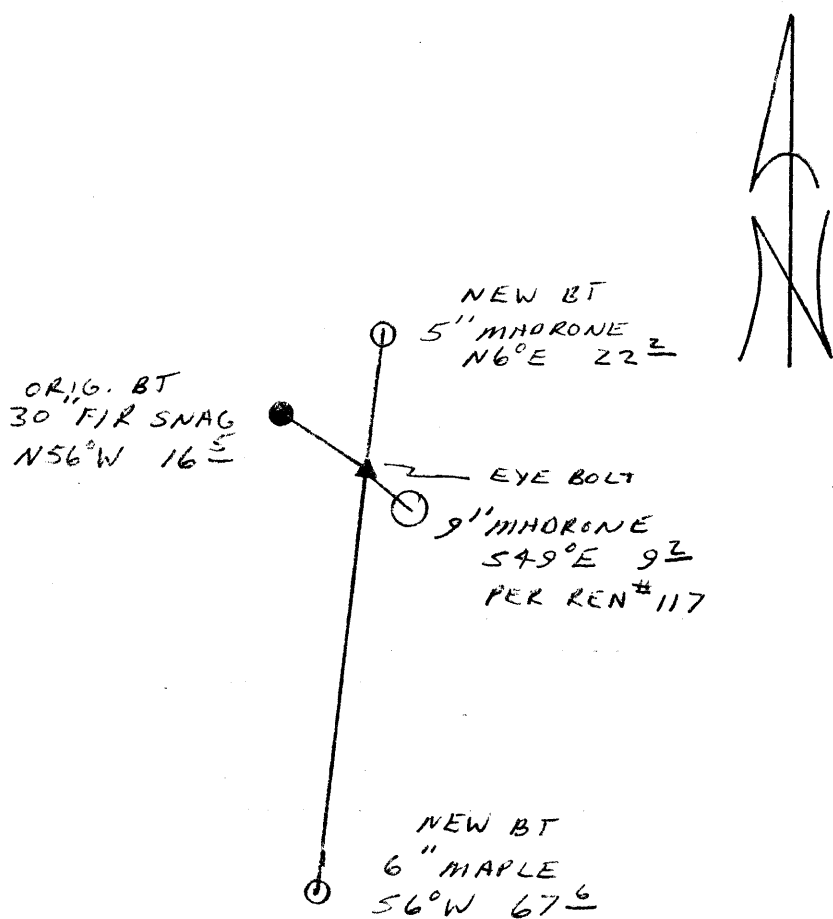

Location & Comments

CORNER LIES ON STEEP WESTERLY SLOPE.

Comp. Declin. 18°E
Agency DCSD
Party Chief RANDALL W SMITH
Notekeeper Randall W Smith
Witnesses STEPHEN J FLAUSE

Address

Surveyor's Seal

REGISTERED PROFESSIONAL LAND SURVEYOR

Larry E. Monrean

OREGON JULY 13, 1979 LARRY E. MONREAN #1830