

GOVERNMENT CORNER RESTORATION FORM

Township 25S Range 8W Sec. 28 County DOUGLAS

State OR Date 10/12/88 No. _____

Corner Designation

ONLY | S28
| S33

- Condition Report Only
- Not Found
- Renewed
- Unrecorded
- Surveyed In
- Referenced Out

Previous Renewals 1911 RESURVEY, #59, 1972 RESURVEY

Monument(s) Found: (Condition and Source)

A 2 1/2" DIA. BRASS CAP ON A 1 1/2" O.D. IRON PIPE THAT MEASURES 36" LONG IS LAYING ON TO OF GROUND OUT OF POSITION.

COUNTY SURVEYORS OFFICE
T25S

| S28
| S33
R8W
1968

Accessories Found:

TWO BEARING TREES FROM 1911 RESURVEY ARE FOUND, NO OTHER BT'S LOCATED.

24" NOW 27" DIA. ROTTED 5FT HIGH D. FIR STUMP WITH SCRIBING VISIBLE ON UPPER BLAZE " 5 8 R 8 " BEARS N70°E, 31.0 FT (AGREES WITH RECORD). A BT TAG ON STUMP WITH INITIALS HWT SHOWS A BEARING OF N82°W, DISTANCE 23 FT SOURCE UNKNOWN.

29" NOW 39" DIA. 4 FT HIGH D. FIR STUMP WITH ILLEGIBLE SCRIBING VISIBLE IN A PREVIOUSLY OPENED UPPER BLAZE, BEARS N88°E, 40.3 FT (RECORD N88°E, 42.4, DISTANCE IS A SLOPE MEASUREMENT FROM REN. #59) AGREES WELL WITH 1972 RESURVEY.

#114x

RENEWAL

Monument Set (Procedure and Description)

POSITION OF CORNER DETERMINED FROM TWO 1911 RESURVEY RENEWAL BEARING TREES AT BEARING'S AND DISTANCES SHOWN ON FRONT PAGE UNDER ACCESSORIES FOUND. POSITION IS REFERENCED AND 1968 DCSO BC/IP WITH MARKS "RESET 1988" ADDED IS SET. A 2 FT DIA MOUND OF SAND STONE IS PLACED AROUND BC/IP BRASS CAP PROTRUDES 4 IN ABOVE MOUND OF SAND STONE.

Monument Detail

COUNTY SURVEYORS OFFICE
T255

RESET | S28
1988 | S33


R8W
1968

New Accessories

6" HEMLOCK DOUBLE BLAZED AND SCRIBED "T255 R8W S33 CS BT"
BEARS S70 1/2° E, 49.2 FT.

5" CEDAR DOUBLE BLAZED AND SCRIBED "X BT"
BEARS N31° E, 50.6 FT.

Sketch of Monument, Accessories, and General Area

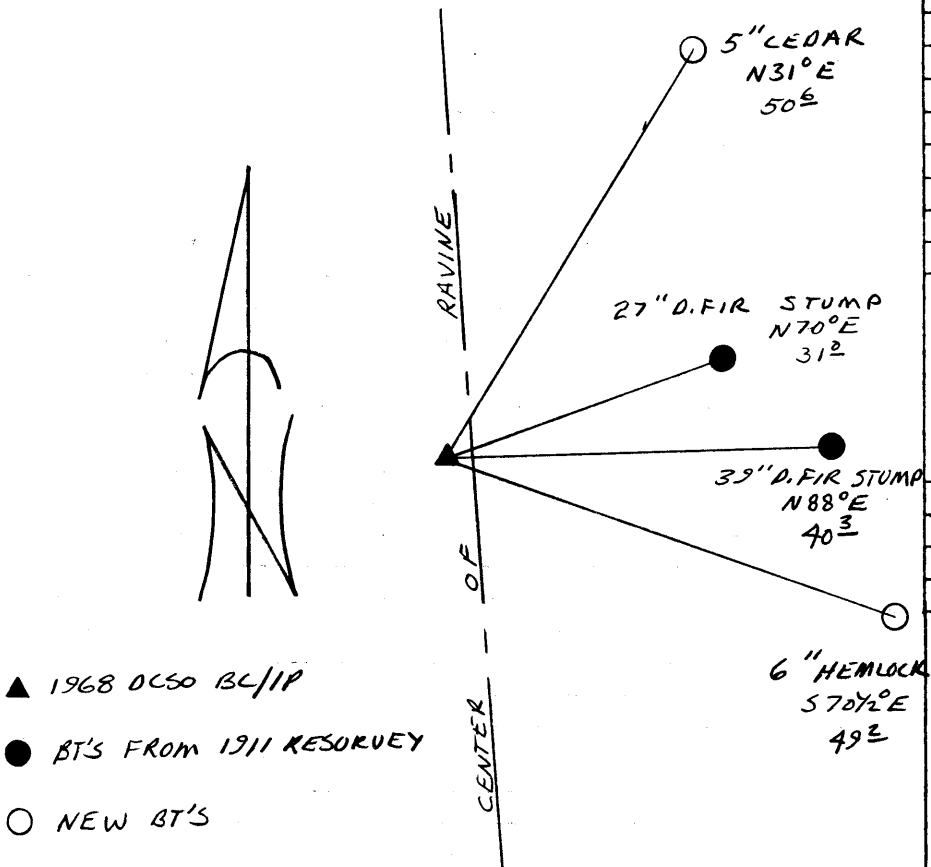

Location & Comments

CORNER LIES ON A STEEP NORTH SLOPE AT THE WEST EDGE OF A NORTHERLY RUNNING RAVINE, IN A RECENTLY LOGGED CLEAR CUT.

Comp. Declin. 18 1/2° E
Agency DCSO
Party Chief RANDALL W. SMITH
Notekeeper Randall W. Smith
Witnesses STEPHEN J. FLAUSE

Address

Surveyor's Seal

REGISTERED
PROFESSIONAL
LAND SURVEYOR

Larry E. Monrean

OREGON
JULY 13, 1979
LARRY E. MONREAN
#1830