

GOVERNMENT CORNER RESTORATION FORM

Township 255 Range 8W Sec. 29 County DOUGLAS

State OREGON Date 10/12/88 No. \_\_\_\_\_

Corner Designation

CC 529  
532

Condition Report Only  
Not Found  
 Renewed  
Unrecorded  
Surveyed In  
Referenced Out

Previous Renewals RENEW #58, AND BLM 1972 RESURVEY  
Monument(s) Found: (Condition and Source)

MONUMENT DETAIL

COUNTY SURVEYORS OFFICE

T255

A 2 1/2 INCH DIAMETER BRASS CAP MARKED AS AT RIGHT ON A 1 1/4 O.D. IRON PIPE, 36 INCHES LONG, OUT OF GROUND AND OUT OF POSITION ON A STEEP HILLSIDE. MONUMENT SET IN RENEWAL #58, NO EVIDENCE OF 1911 CEDAR POST FOUND.

529 | C.C.  
532 |

R8W  
1968

Accessories Found:

ONE ORIGINAL BEARING TREE FOUND. A FIR 30 INS. DIAM. NOW A 36 INCH D.B.H. DOUGLAS FIR SNAG WITH A PREVIOUSLY OPENED BLAZE, SHOWING A "2" AND OTHER ILLEGIBLE SCRIBING, BEARS S 80°W, 5 3/4 FEET DIST. (AS PER ORIGINAL RECORD). OTHER O.B.T. NOT FOUND.

TWO BEARING TREES FROM RENEWAL #58 FOUND. A 13" HEMLOCK NOW A 16 INCH D.B.H. HEMLOCK WITH A PARTIALLY HEALED SINGLE BLAZE REVEALING ILLEGIBLE SCRIBE MARKS BEARS N 38°W, 21 3/8 FEET DISTANT (AS PER BLM RESURVEY RECORD). A 7" HEMLOCK NOW AN 8 INCH D.B.H. HEMLOCK WITH A FULLY HEALED SINGLE BLAZE BEARS S 54°W, 20 3/8 FEET DISTANT (AS PER RENEWAL #58).

A PREVIOUSLY UNRECORDED BEARING TREE FOUND IN BLM RESURVEY BEARING N 19°W IS GONE, POSSIBLY REMOVED BY LOGGING.

A PREVIOUSLY UNRECORDED CORNER REFERENCE A 40 INCH DIAMETER 24 INCH TALL DOUGLAS FIR STUMP CUT AS A LOGGING CABLE ANCHOR WITH NO EVIDENCE OF BLAZES OR SCRIBING BEARS N 18 1/2°W, 30 3/4 FEET DISTANT (METAL TAG ON STUMP RECORDS BEARING AND DISTANCE AS N 16 1/2°W, 28 3/4 FEET).

#1154

RENEWAL

Monument Set (Procedure and Description)

Monument Detail

THE CORNER POSITION, AS DETERMINED FROM THE FOUND BEARING TREES DESCRIBED PREVIOUSLY, IS MONUMENTED WITH A PK NAIL DRIVEN INTO A SMALL LEDGE OF BED ROCK CHISELLED OUT FOR THIS PURPOSE.

DIRECTLY PLUMB OVER THE ABOVE PK NAIL IS SET THE FOUND BRASS CAP MONUMENT NOW MARKED AS AT RIGHT. A ROUGH MOUND OF STONE IS BUILT UP AROUND THE B.C. MONUMENT. MONUMENT NOW PROTRUDES 7 INCHES ABOVE MOUND OF STONE.

COUNTY SURVEYORS OFFICE

T255

529

C. C.

532

RESET

1988

KBW


1968

New Accessories

NO

Sketch of Monument, Accessories, and General Area

- O.B.T
- RENEWAL #58 BT
- ▲ UNRECORDED BT

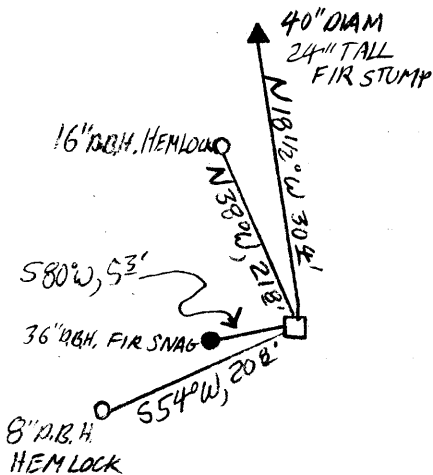

Location & Comments

CORNER LIES ON STEEP NORTHERLY SLOPE NEAR CREST OF EASTERLY RUNNING SPUR RIDGE. CORNER IS IN OLD GROWTH TIMBER NEAR EDGE OF RECENT CLEAR CUT.

Comp. Declin. 18 1/2 ° F  
Agency DC50  
Party Chief R.W. SMITH  
Notekeeper Stephen John Flaise  
Witnesses STEPHEN JOHN FLAISE

Address

Surveyor's Seal

REGISTERED  
PROFESSIONAL  
LAND SURVEYOR

*Signature of Larry E. Monrean*

OREGON  
JULY 13, 1979  
LARRY E. MONREAN  
#1830